

Key

Timber post and 5 rail motorway fence with wire mesh, line wires and barbed wire as per standard detail ACC/SD/39 on drawing ATKSCW/901/004

Timber post and 5 wire fence with mesh as per standard detail ACC/SD/16 on drawing ATKSCW/901/001

Mammal guidance fencing as per detail drawing S001DSG/M77/DR/SK253A

Close boarded timber fence to BS 1722 Part 5 or 6 to match that used on Ayr Road Route Scheme

Dry pipe crossing

Existing structure to have mammal ledge

Close boarded fence as per MCDHW Vol. 3 drawing H14



Anti dazzle mesh attached to full height of boundary fence. Tenax shade and shelter or similar. Refer to drawing S001DSG/M77/DR/SK095 for details

Combined mammal and boundary fencing as per detail dwg S001DSG/M77/DR/SK010.

Gate Type G1 as per ACC/SD/20 on drawing ATKSCW/901/001

Gate Type G2 as per ACC/SD/21 on drawing ATKSCW/901/001

Gate Type G3 as per drawing S001DSG/M77/DR/F03/030

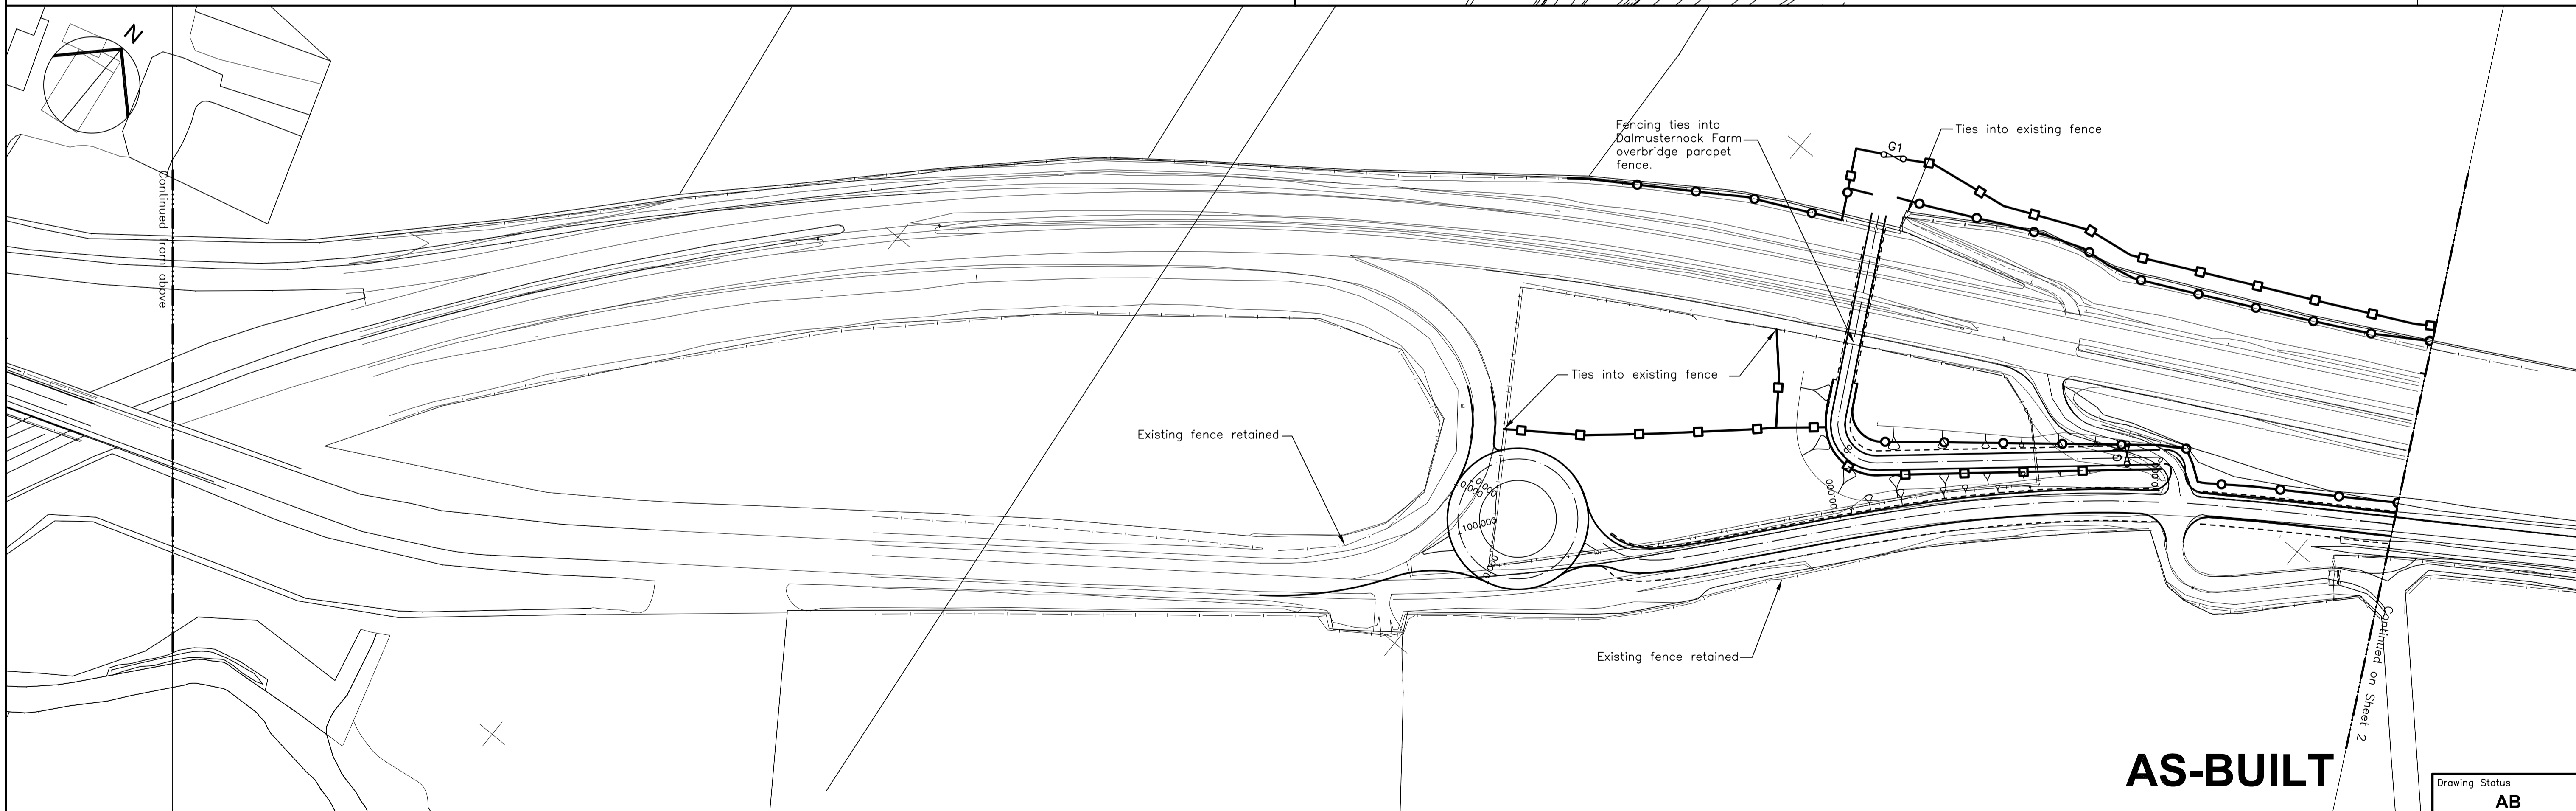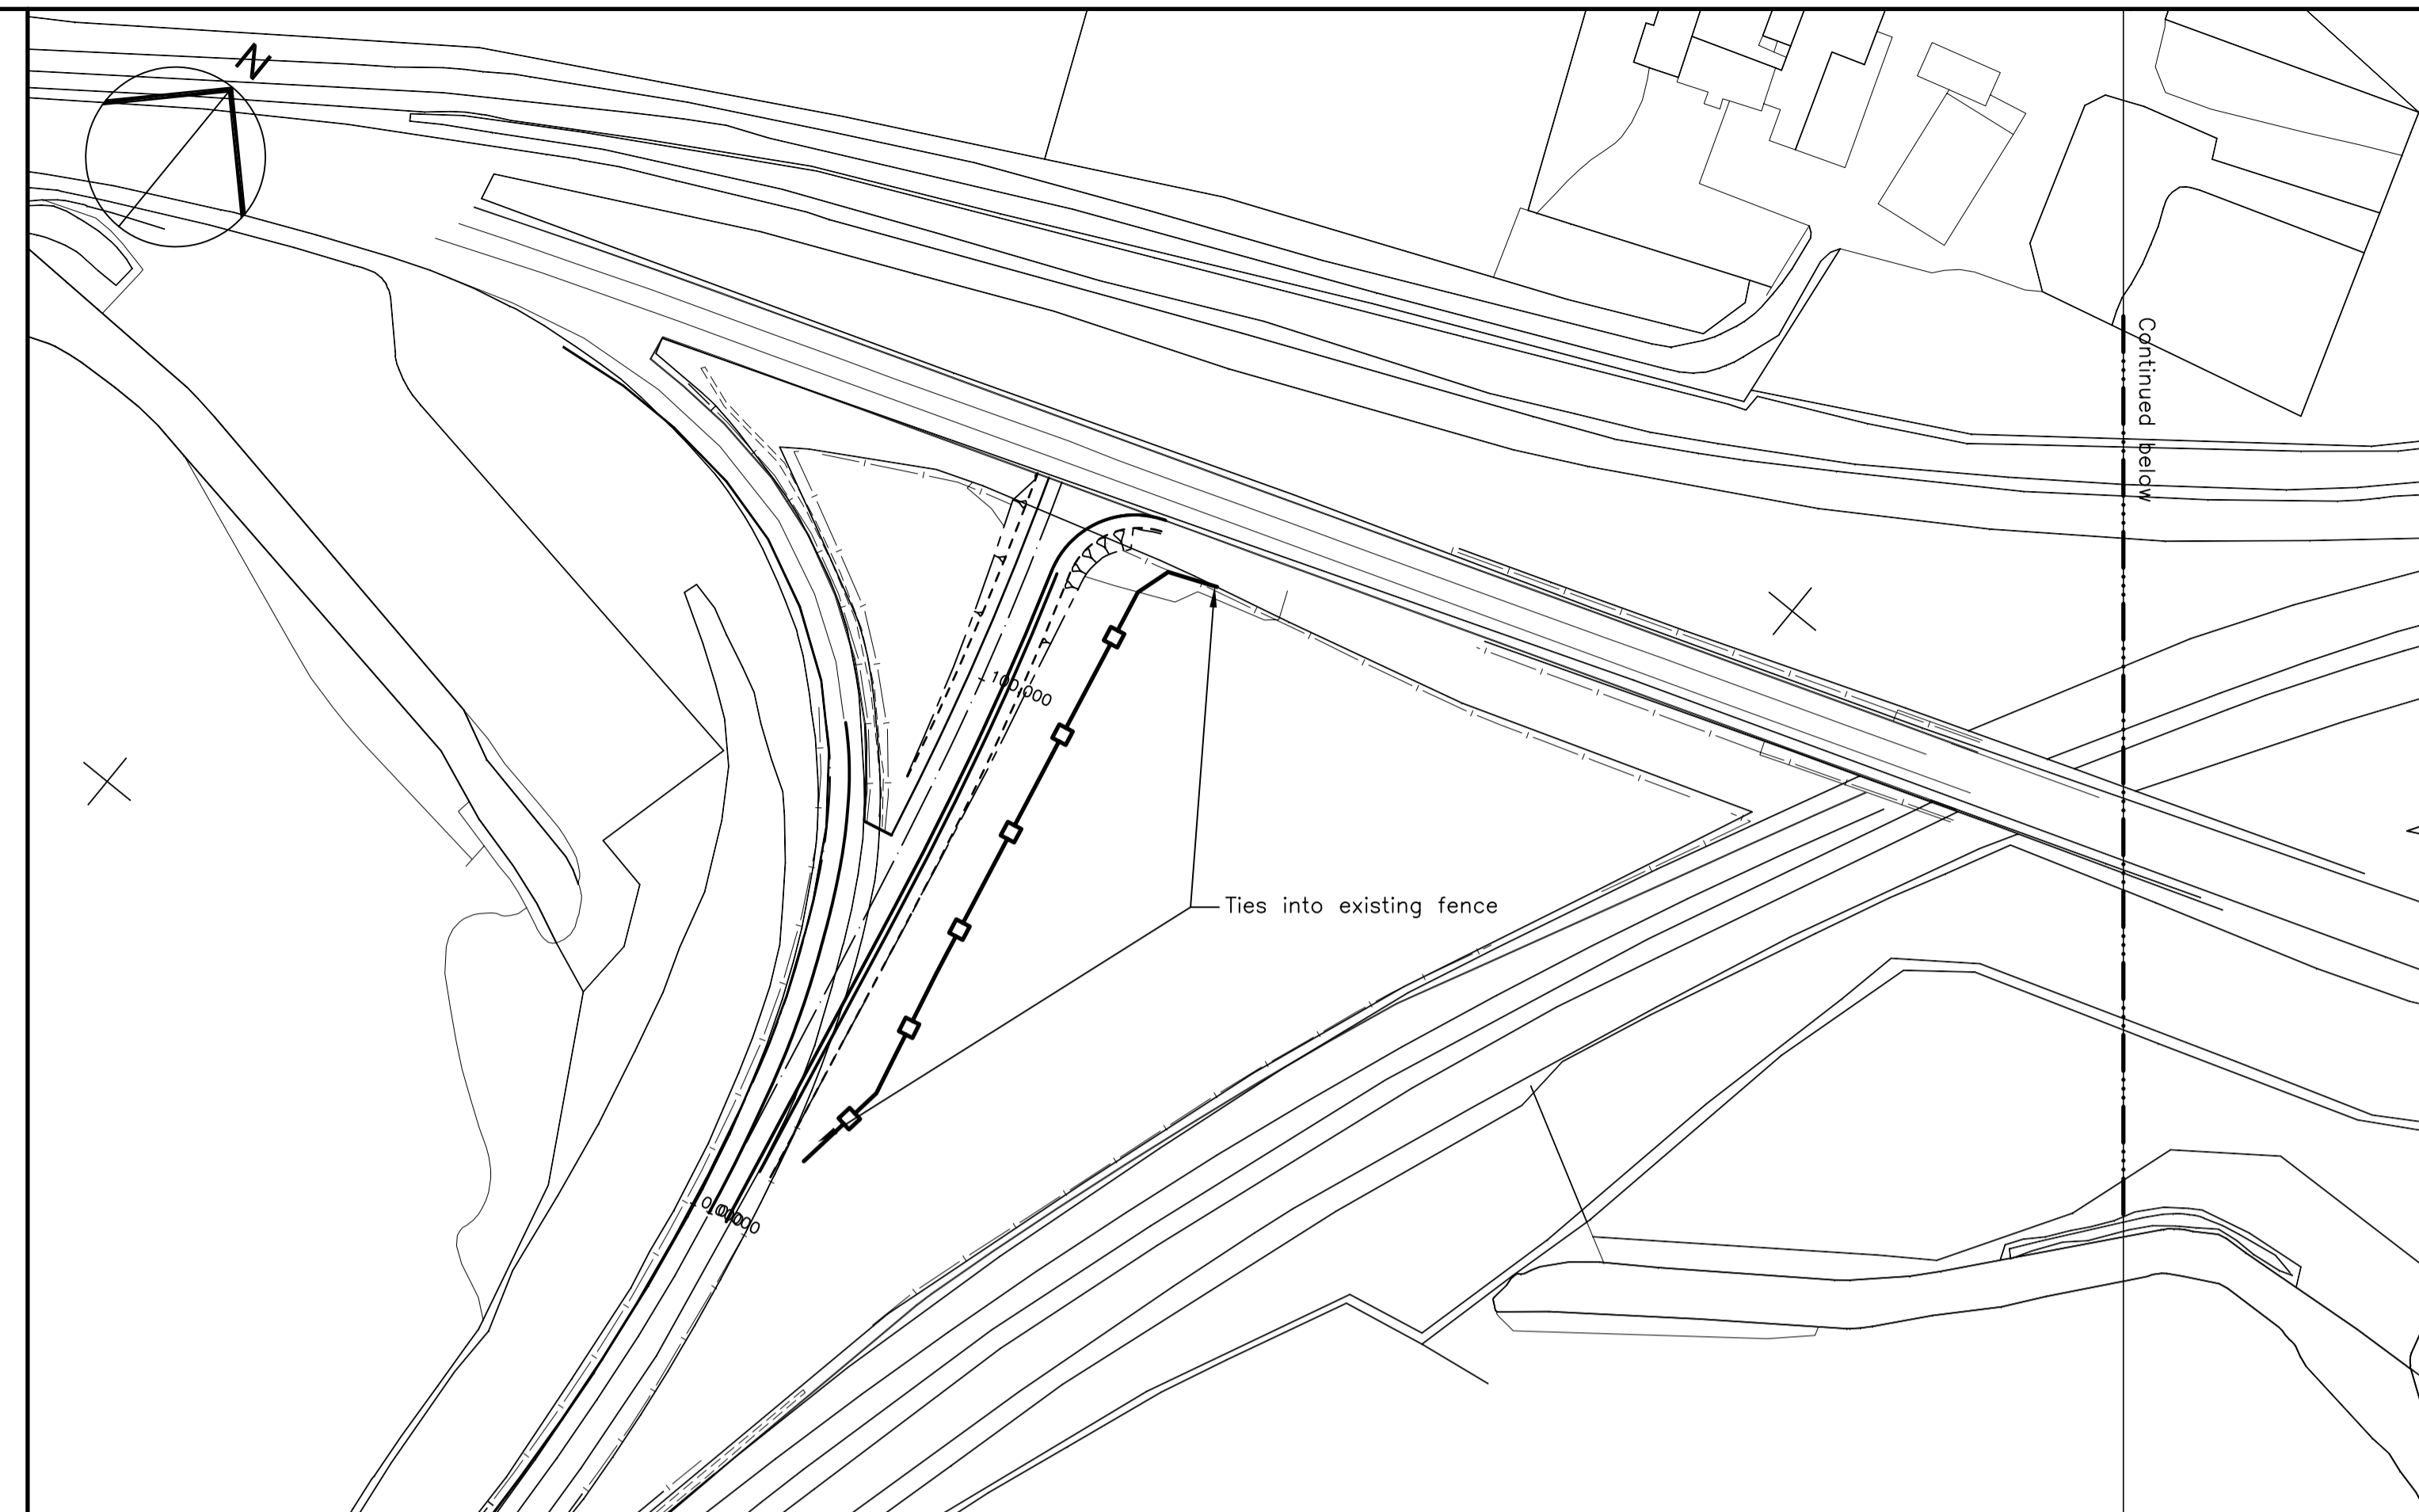

AS-BUILT

Drawing Status
AB

Notes :





Rev	Description	By	Date	Chk'd	App'vd	Purpose of Issue	Rev	Client
K	Revised as per site notes	JB	03/11/05	DW	KOH	As Built	K	
J	Updated to As Built status	PC	08/08/05	DW	KOH	As Built	J	
I	Anti dazzle added to Key	LW	23/03/05	PA	P.A.	For Construction	I	
	DCR/AWG/190 incorporated							
H	Roadbase amended	LW	14/02/05	PA	P.A.	For Review	H	
G	Anti-dazzle measures added to key	PC	26/01/05	PA	P.A.	For Construction	G	
F	Minor amendment. Legend amended	LW	04/10/04	PA	P.A.	For construction	F	
E	Fencing & key amended. Sheet 13 added.	PC	24/05/04	FD	P.A.	For construction	E	
D	Fence line amended	LW	01/04/04	FD	P.A.	For review	D	

Connect

Project		M77 FENWICK - MALLET SHEUGH GLASGOW SOUTHERN ORBITAL (GSO) DBFO			Full Size
Title		FENCING LAYOUT SHEET 1 OF 13			A1
Scale	1:1000	Drawn	Checked	Approved	Drawing No.
		L.W.	P.A.	P.A.	S001DSG/DR/M77/F03/011
		Date	Date	Date	Rev
		17/02/03	17/02/03	17/02/03	K

Drawing Name & Location:
Plot Date:

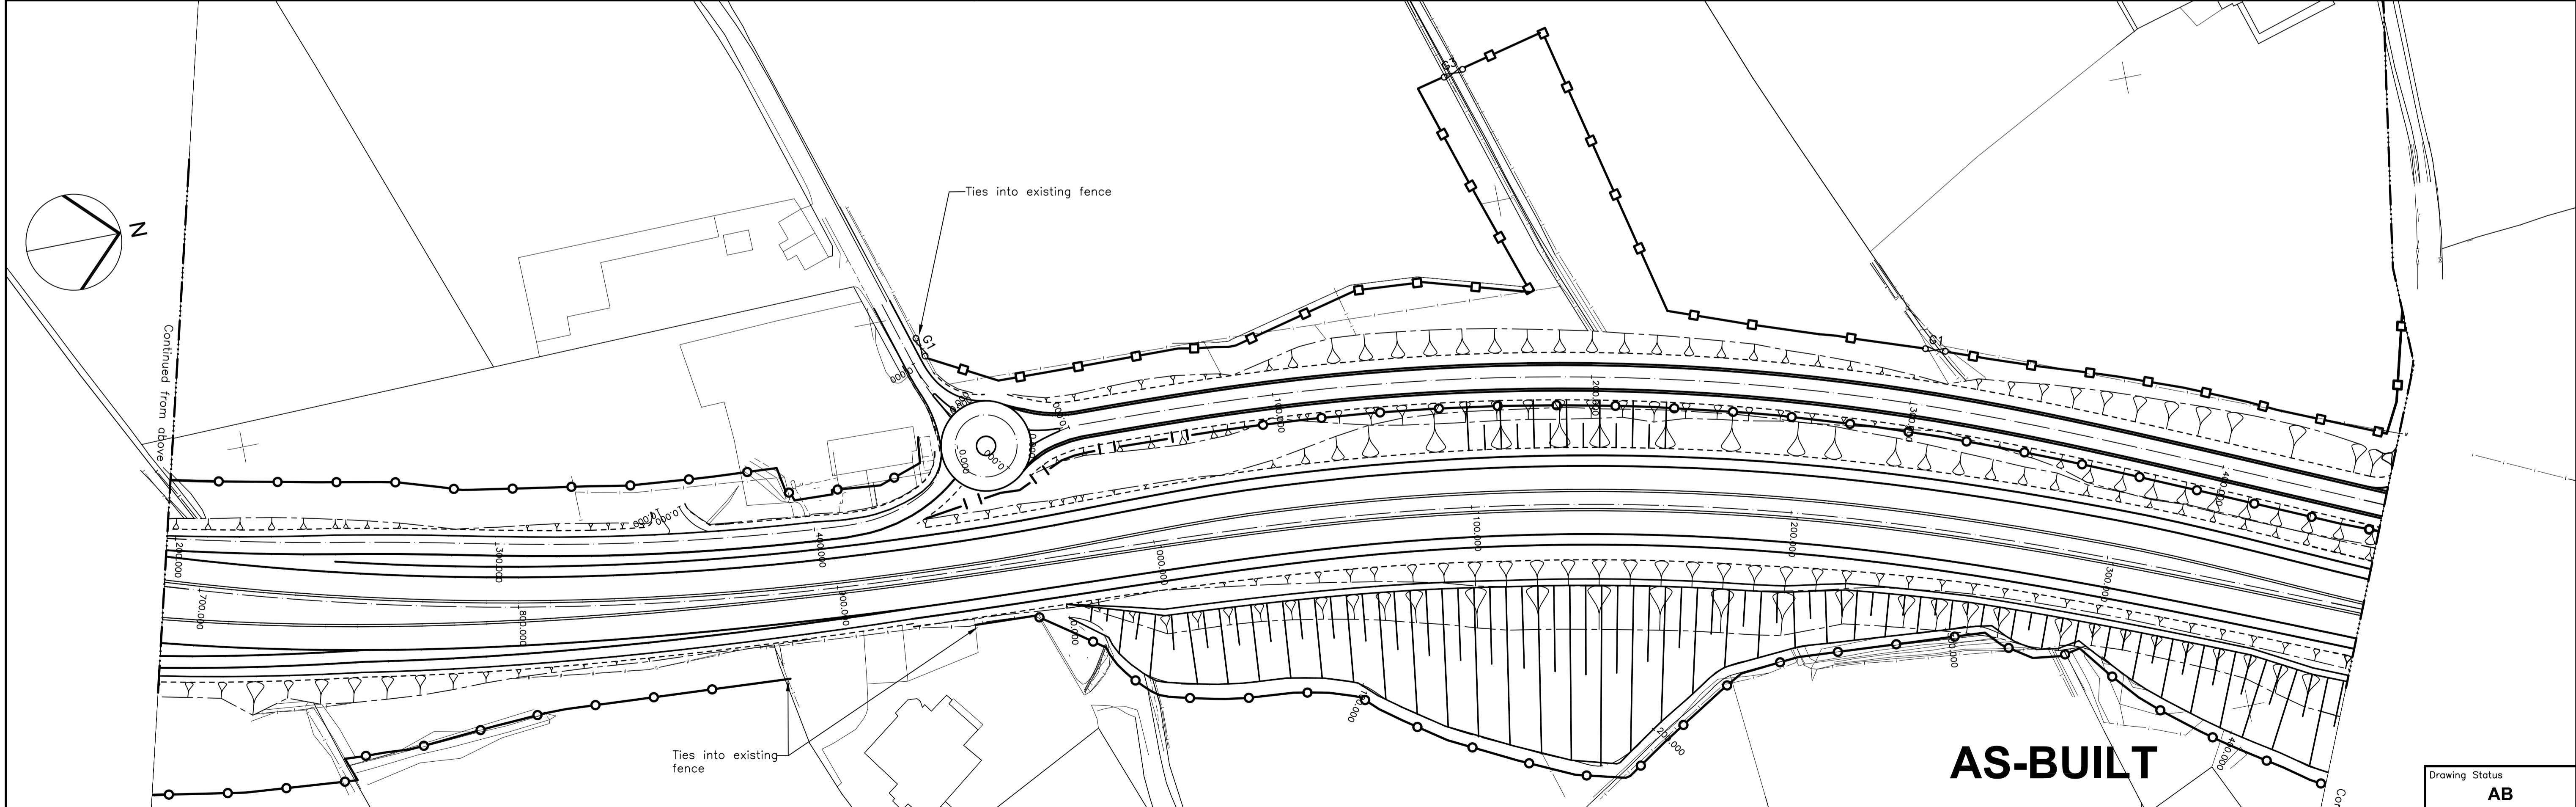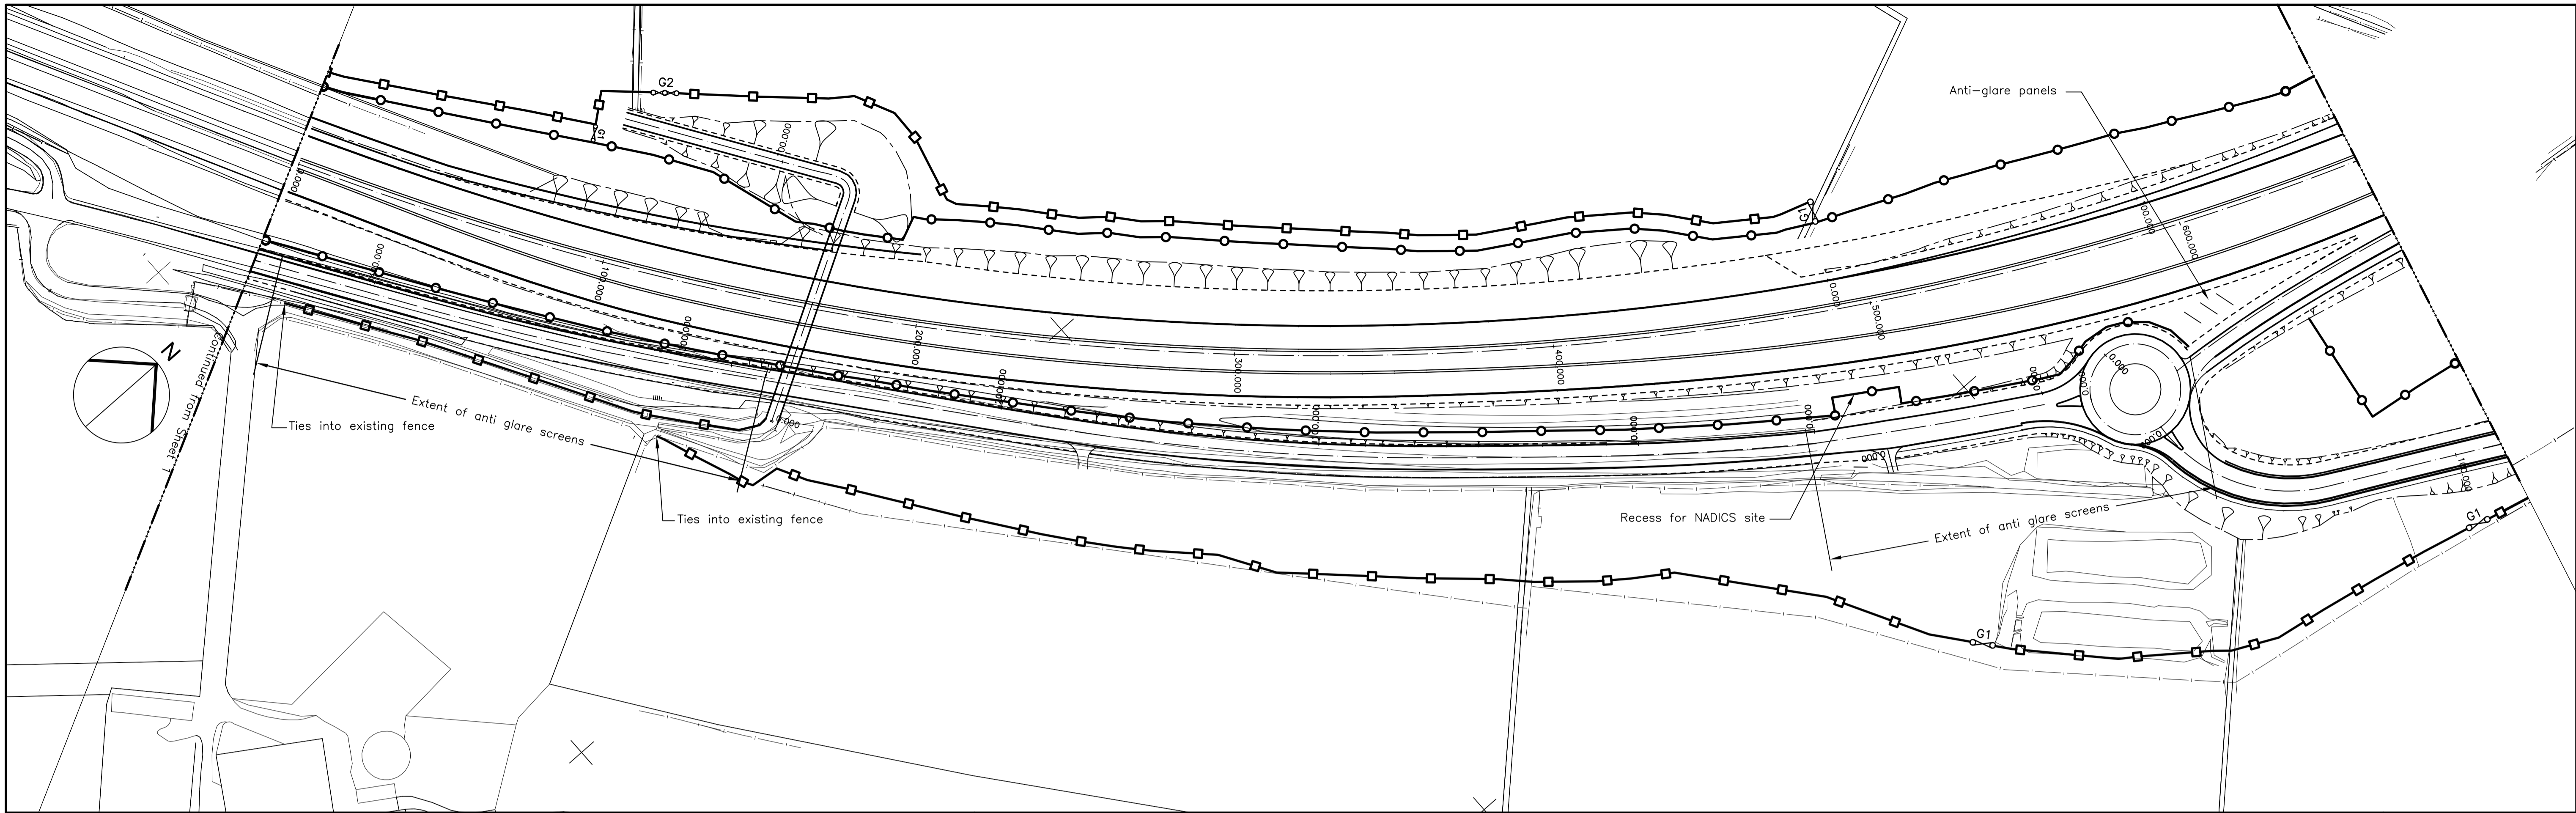

AS-BUILT

Drawing Status
AB

Notes :
For all notes refer to sheet 1




Rev	Description	By	Date	Chk'd	App'vd	Purpose of Issue	Rev	Client
O	Revised as per site notes	JB	03/11/05	DW	KOH	As Built	O	
N	Updated to As Built status	PC	08/08/05	DW	KOH	As Built	N	
M	Anti dazzle mesh added	LW	23/03/05	PA	P.A.	For Construction	M	
	DCR/AWG/190 incorporated							
L	Fencing amended	PC	14/03/05	PA	P.A.	For Construction	L	
K	Roadbase amended	LW	14/02/05	PA	P.A.	For Review	K	
J	Anti-dazzle measures added	PC	26/01/05	PA	P.A.	For Construction	J	
I	Fencing amended.	PC	14/01/05	JS	P.A.	For Construction	I	
H	Fencing amended at Fenwick Roundabouts	LW	04/10/04	PA	P.A.	For Construction	H	

Connect

Project		M77 FENWICK - MALLETSHEUGH GLASGOW SOUTHERN ORBITAL (GSO) DBFO			Full Size
Title		FENCING LAYOUT SHEET 2 OF 13			A1
Scale	1:1000	Drawn	Checked	Approved	Drawing No.
		L.W.	P.A.	P.A.	S001DSG/DR/M77/F03/012
		Date	Date	Date	Rev
		17/02/03	17/02/03	17/02/03	O

Drawing Name & Location:
Plot Date:

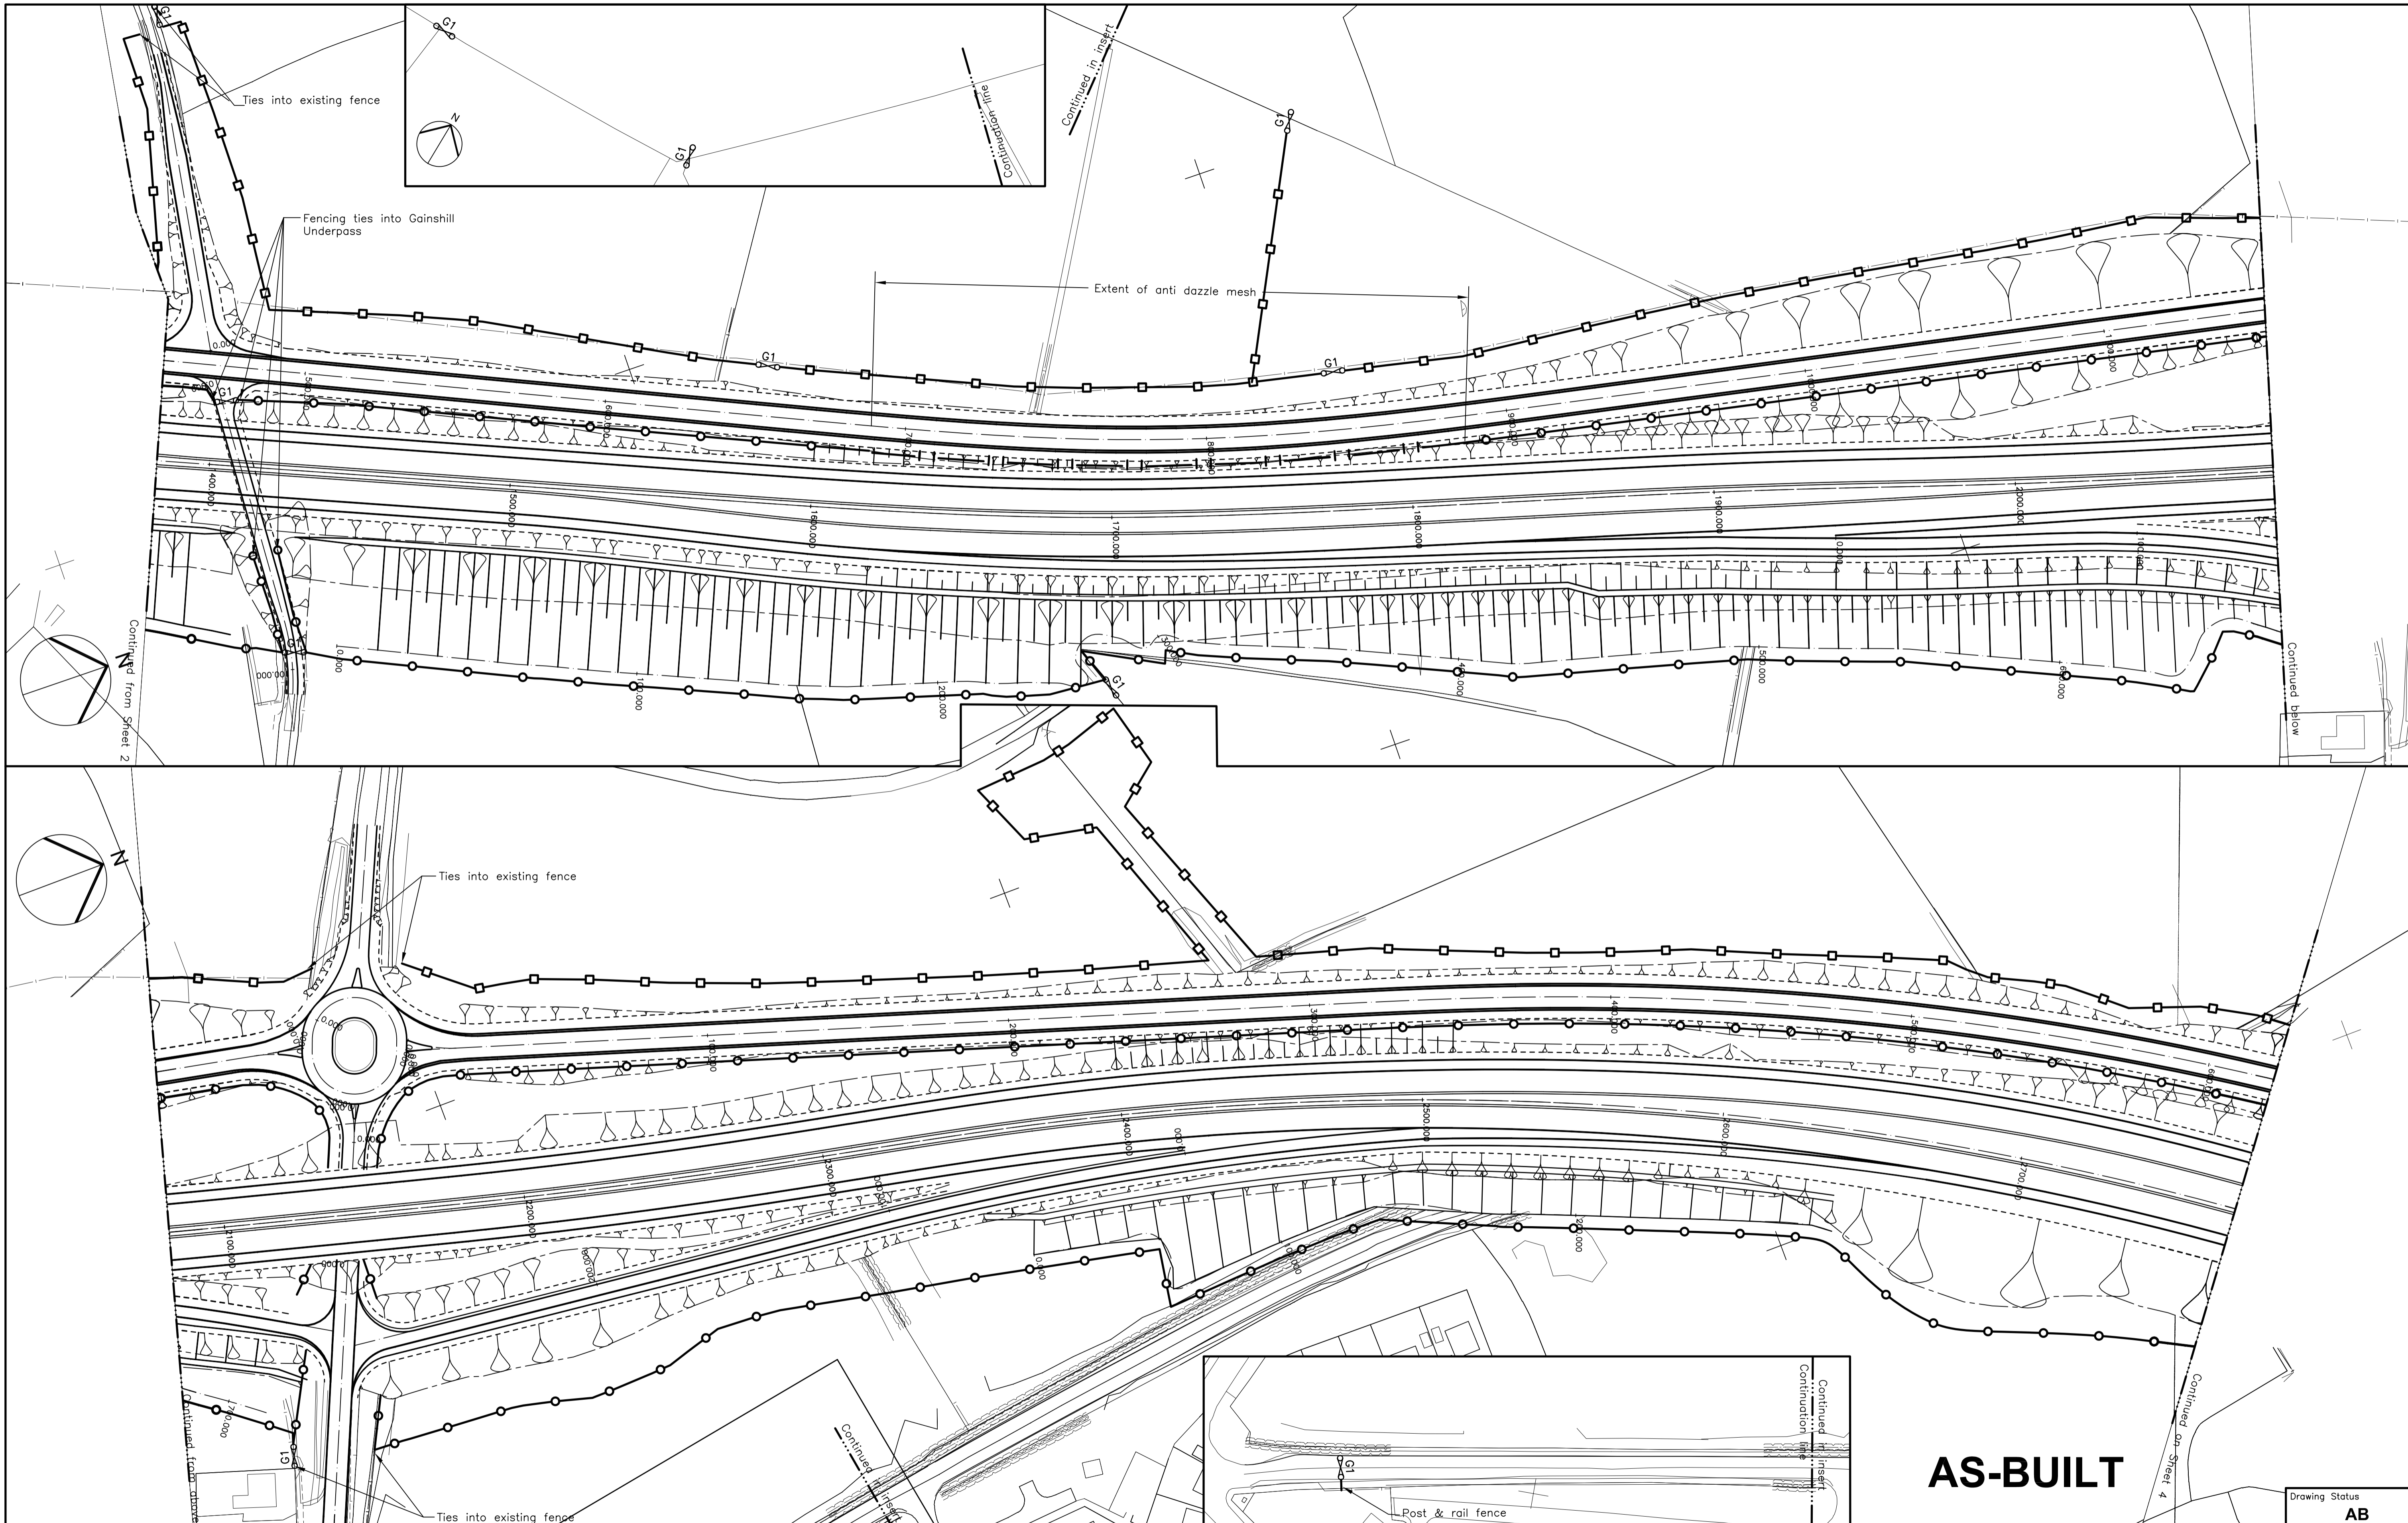

AS-BUILT

Drawing Status
AB


Notes :
For all notes refer to sheet 1



Rev	Description	By	Date	Chk'd	App'vd	Purpose of Issue	Rev	Client
J	Revised as per site notes	JB	03/11/05	DW	KOH	As Built	J	
I	Updated to As Built status	PC	08/08/05	DW	KOH	As Built	I	
H	Anti dazzle mesh added	LW	23/03/05	PA	P.A.	For Construction	H	
G	DCR/AWG/190 incorporated	PC	26/01/05	M.Mc	P.A.	For Construction	G	
F	Anti-dazzle measures added	PC	04/10/04	PA	P.A.	For construction	F	
E	Insert added	PC	24/05/04	FD	P.A.	For construction	E	
D	Fencing added. Sheet 13 added	LW	01/04/04	FD	P.A.	For review	D	
C	Fence line amended	LW	07/01/04	S.C.S	P.A.	For Construction	C	

Project		M77 FENWICK - MALLETSHEUGH GLASGOW SOUTHERN ORBITAL (GSO) DBFO			Full Size
Title		FENCING LAYOUT SHEET 3 OF 13			A1
Scale	1:1000	Drawn	Checked	Approved	Drawing No.
		L.W.	P.A.	P.A.	S001DSG/DR/M77/FO3/013
		Date	Date	Date	Rev
		24/02/03	24/02/03	24/03/02	J

Drawing Name & Location:
Plot Date:

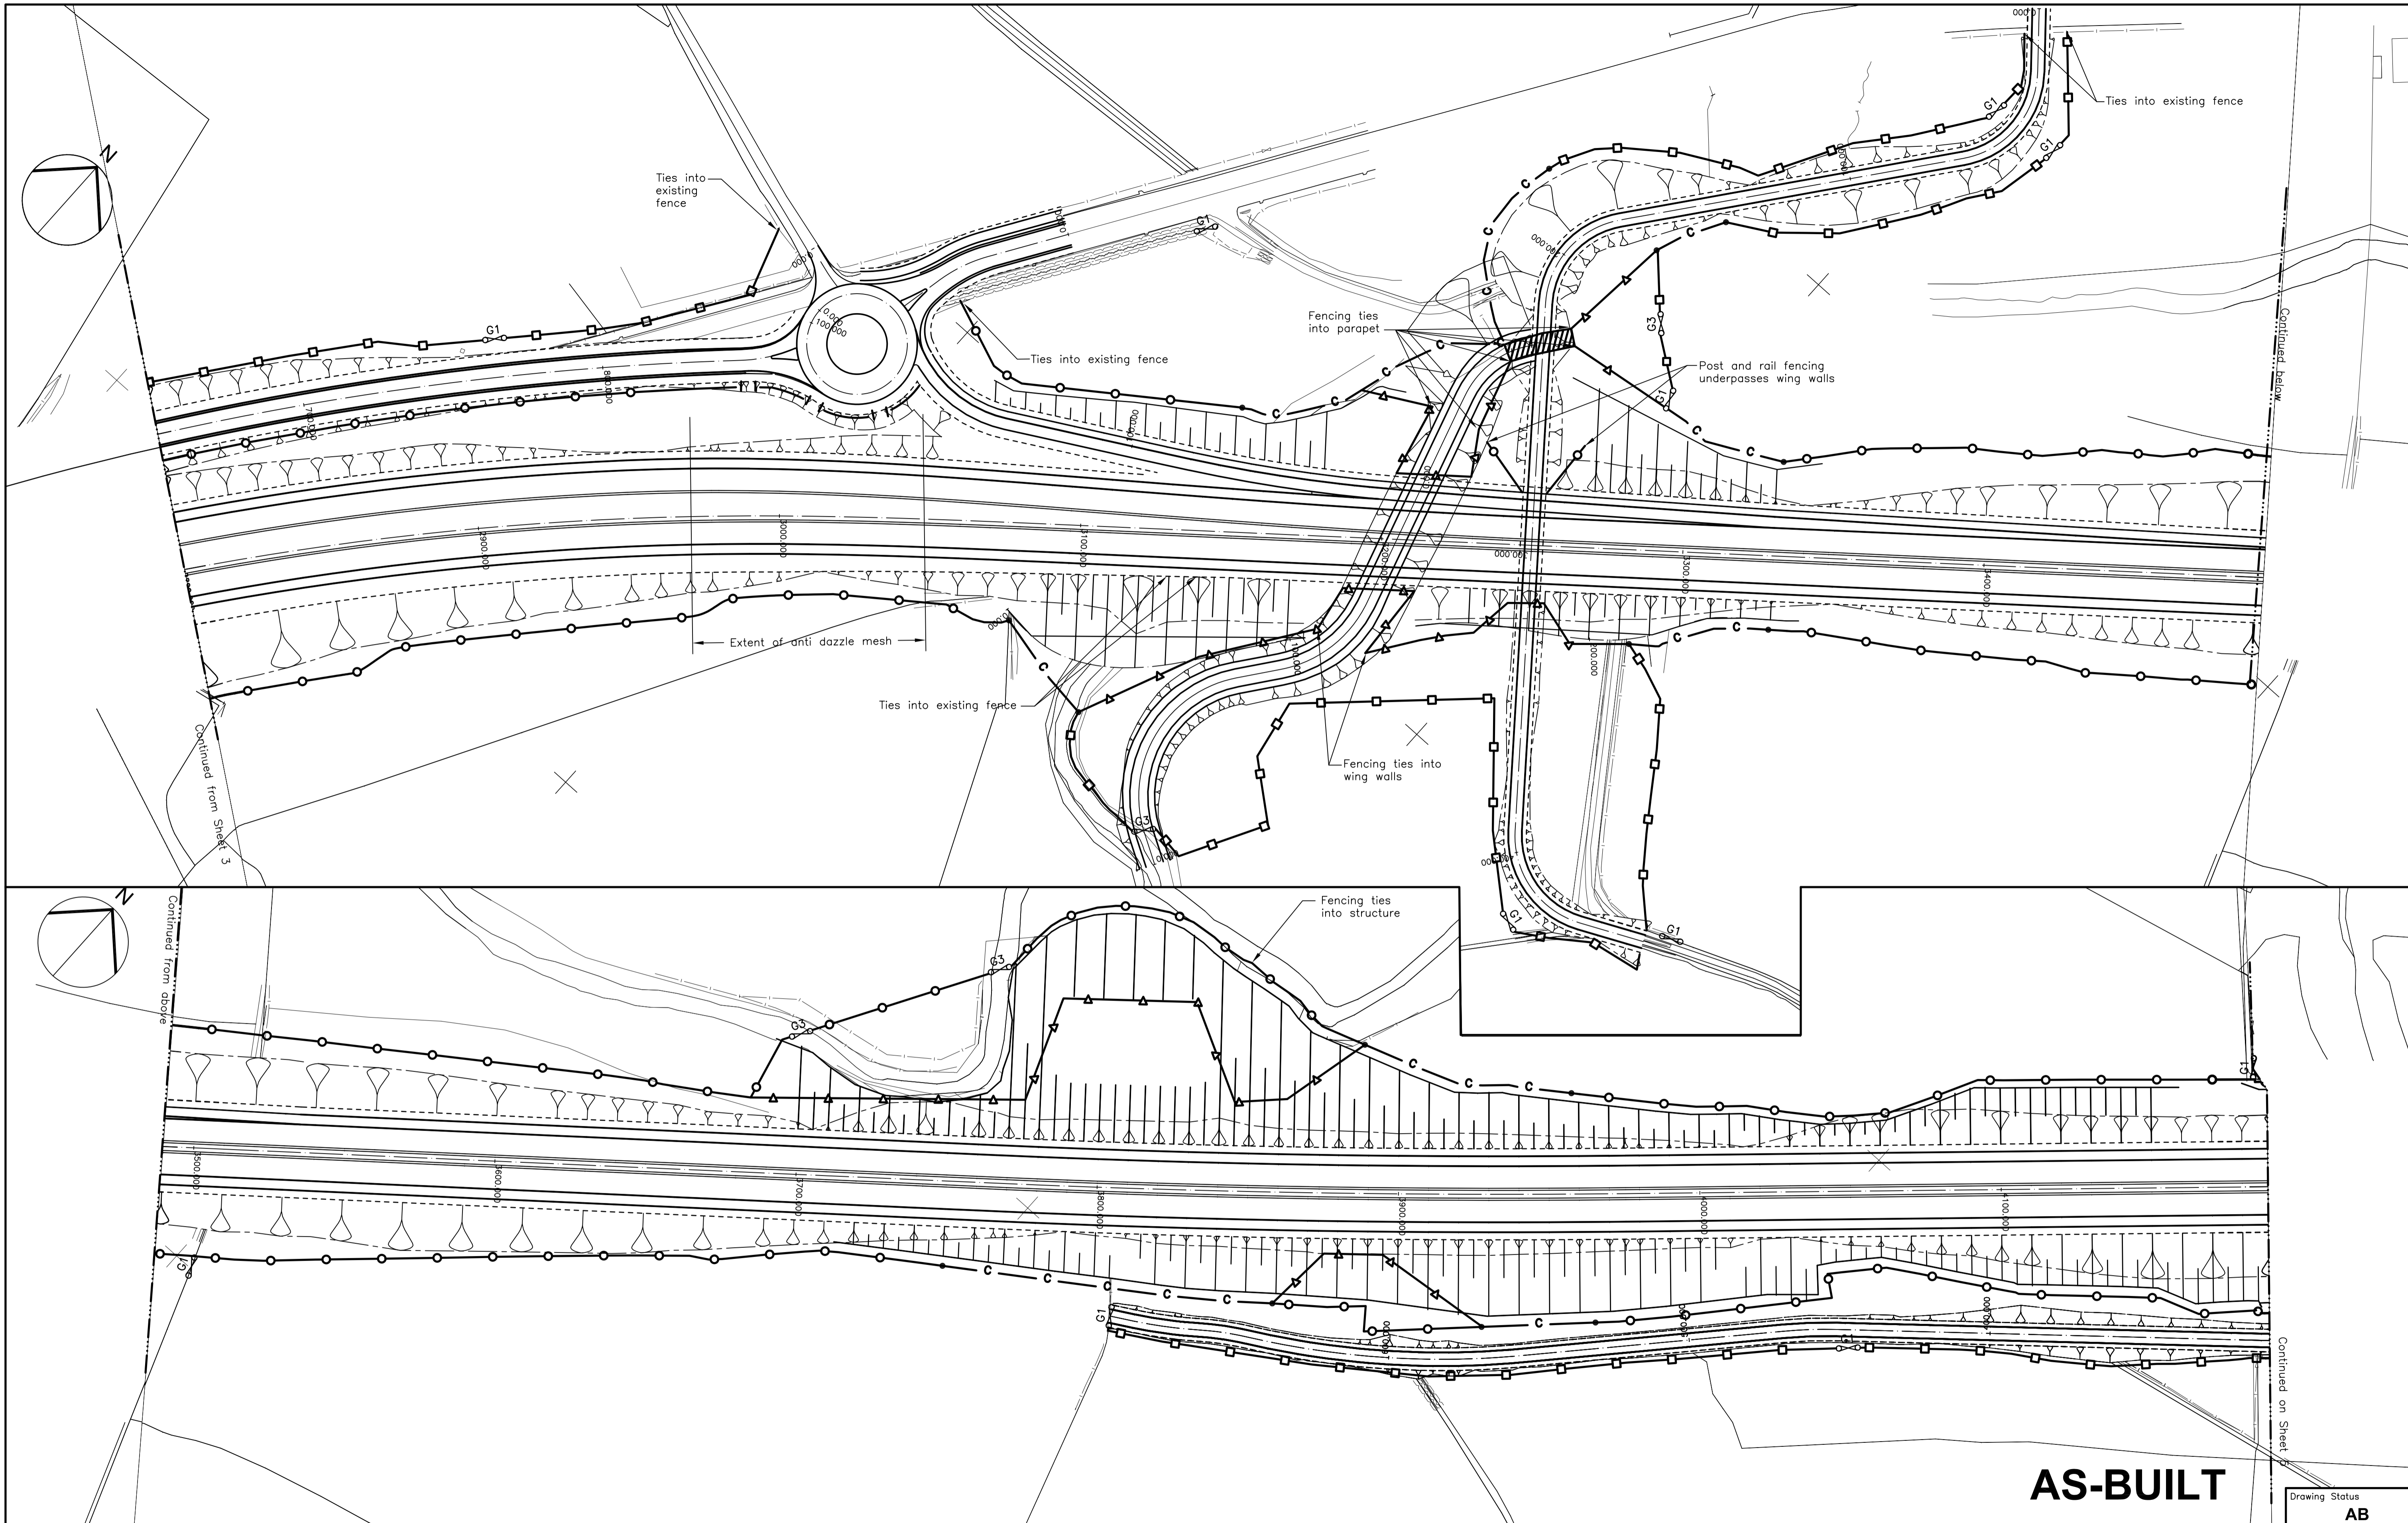

AS-BUILT

Drawing Status
AB

Notes :
For all notes refer to sheet 1




Rev	Description	By	Date	Chk'd	App'vd	Purpose of Issue	Rev	Client
I	Revised as per site notes	JB	03/11/05	DW	KOH	As Built	I	
H	Updated to As Built status	PC	08/08/05	DW	KOH	As Built	H	
G	Anti dazzle mesh added	LW	23/03/05	PA	P.A.	For Construction	G	
DCR/AWG/190 incorporated								
F	Fencing added. Sheet 13 added	PC	24/05/04	FD	P.A.	For Construction	F	
E	Fence line amended	LW	01/04/04	FD	P.A.	For review	E	
D	Dry pipe moved. Fenceline amended	LW	06/01/04	S.C.S	P.A.	For Construction	D	
C	Fenceline amended	LW	15/04/03	MC	P.A.	For Construction	C	
B	Fenceline amended.	LW	24/03/03	M.McI	P.A.	For Construction	B	

Connect

Project		M77 FENWICK - MALLET SHEUGH GLASGOW SOUTHERN ORBITAL (GSO) DBFO			Full Size
Title		FENCING LAYOUT SHEET 4 OF 13			A1
Scale	1:1000	Drawn	Checked	Approved	Drawing No.
		L.W.	P.A.	P.A.	S001DSG/DR/M77/F03/014
		Date	Date	Date	Rev
		24/02/03	24/02/03	24/02/03	I

Drawing Name & Location:
Plot Date:

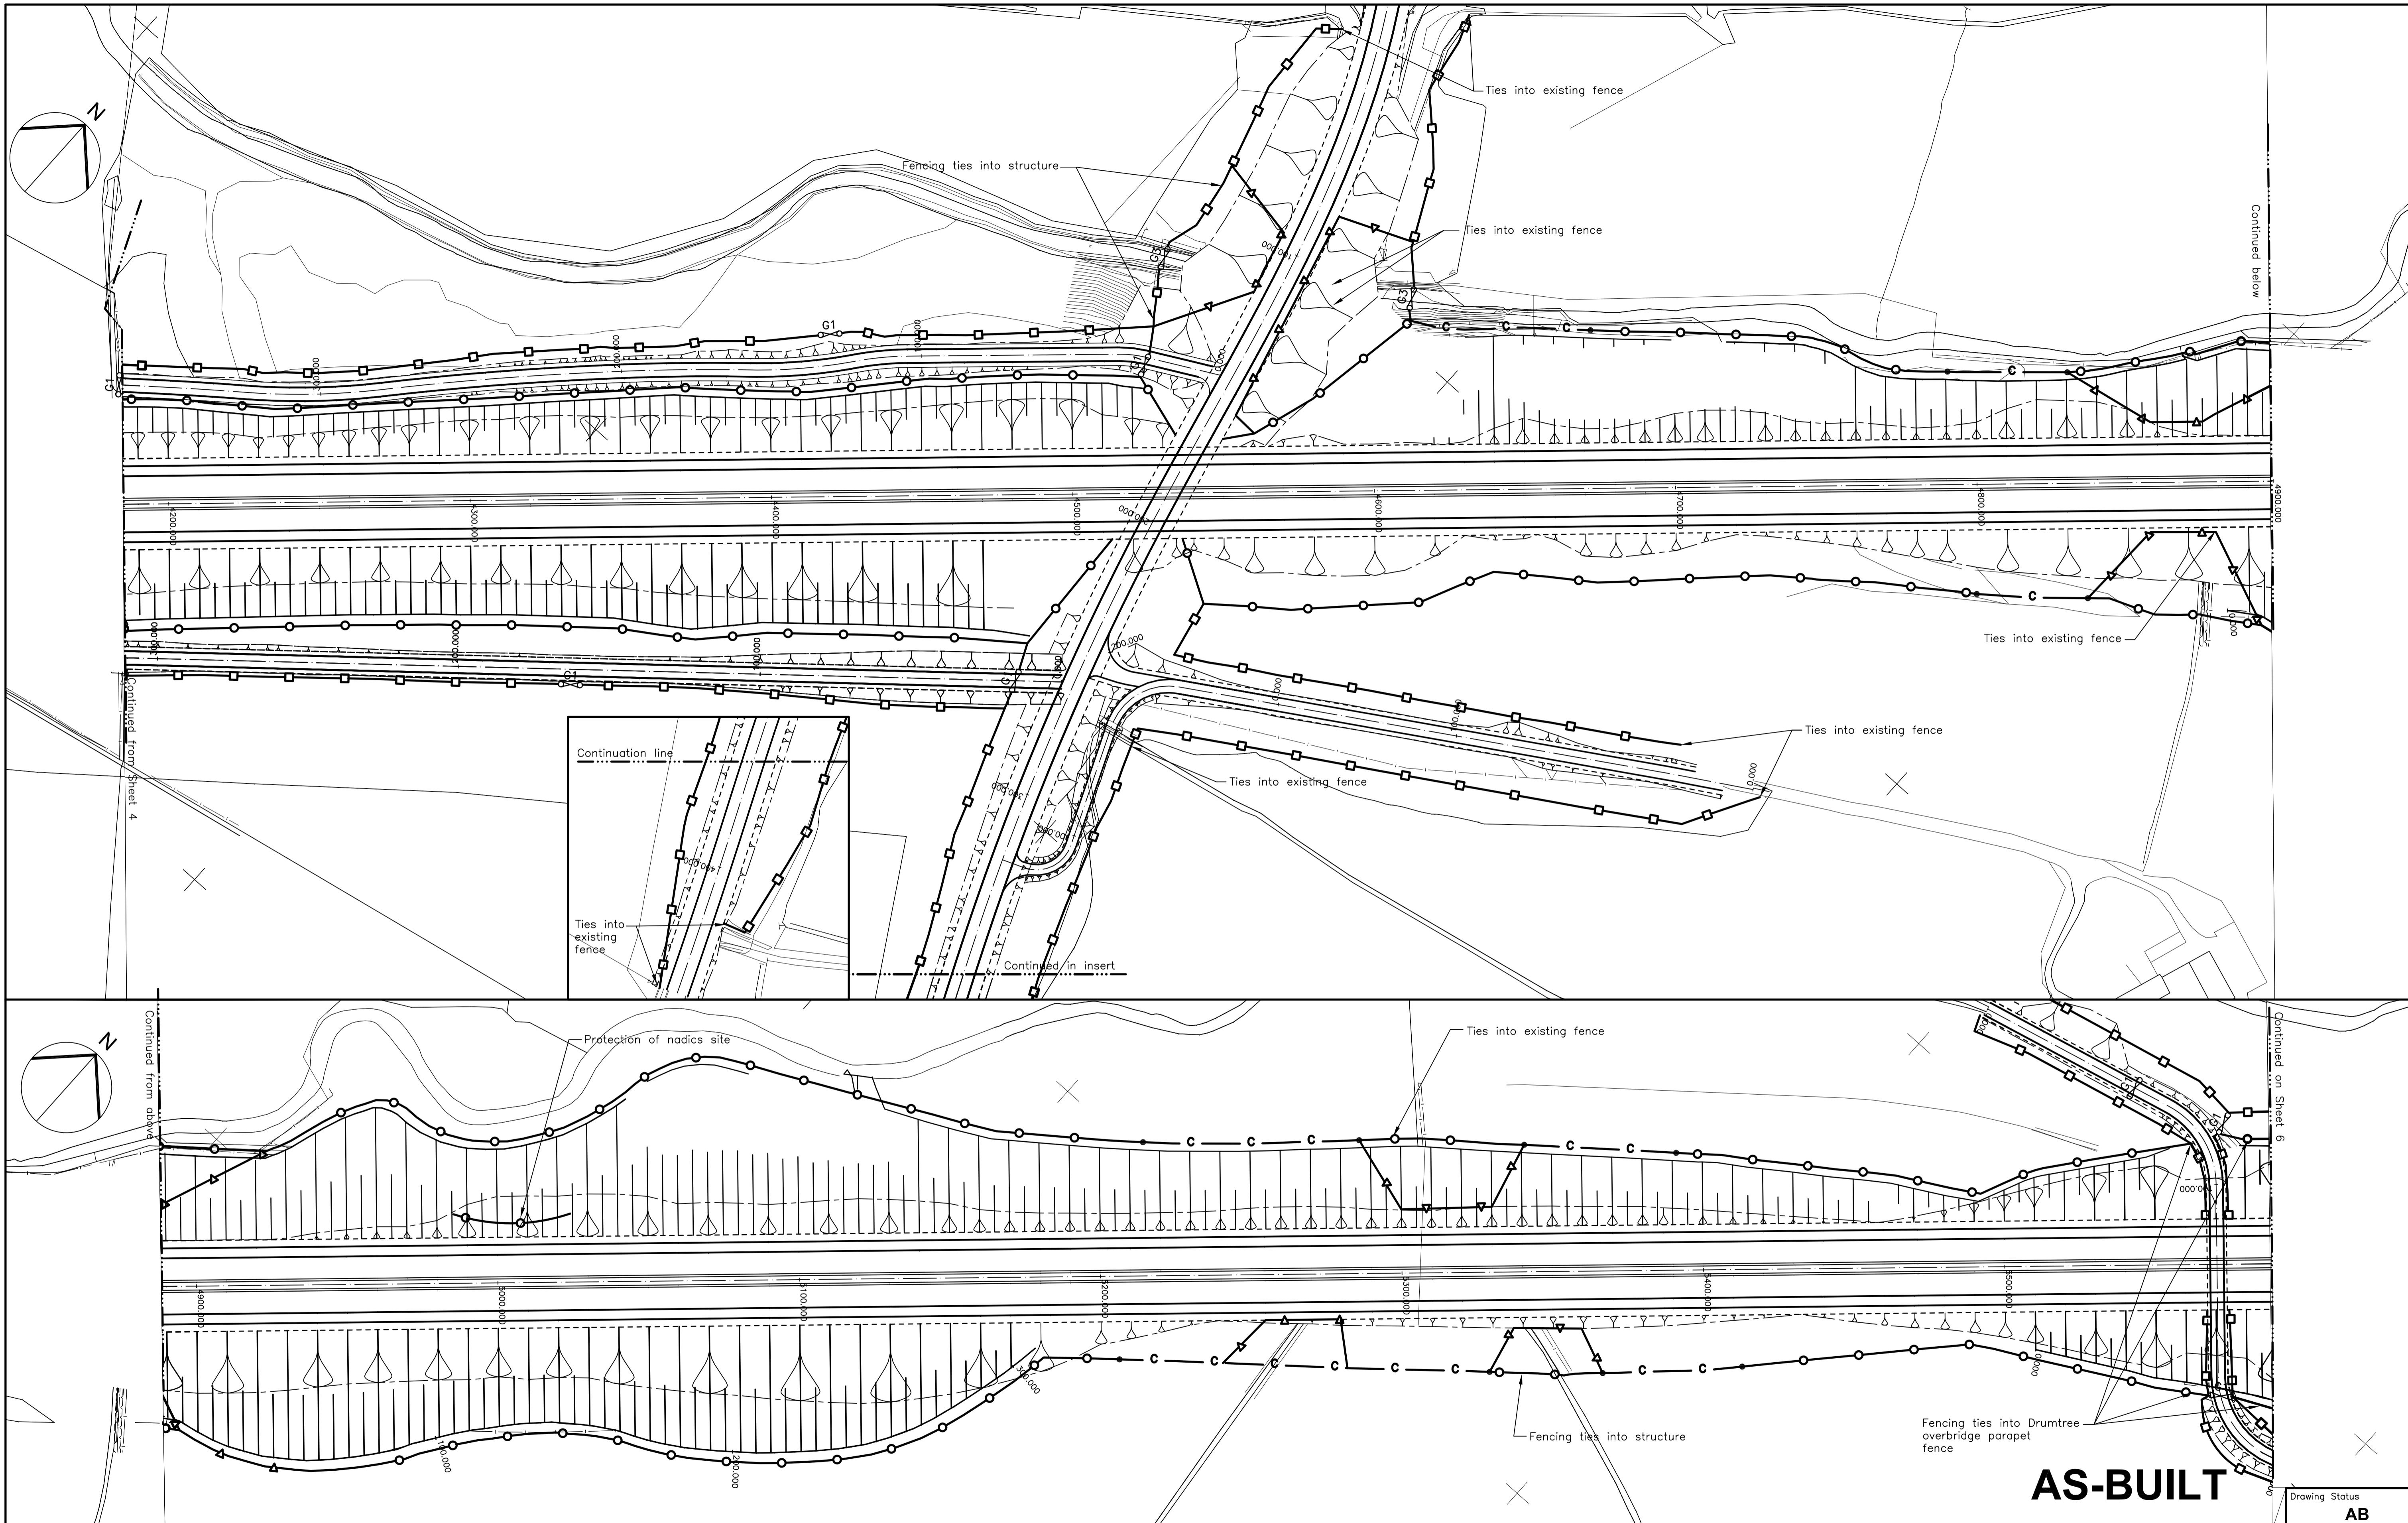

Notes :
For all notes refer to sheet 1




Rev	Description	By	Date	Chk'd	App'vd	Purpose of Issue	Rev	Client
I	Revised as per site notes	JB	03/11/05	DW	KOH	As Built	I	
H	Updated to As Built status	PC	08/08/05	DW	KOH	As Built DCR/AWG/210	H	
G	Fencing added. Sheet 13 added	PC	24/05/04	FD	P.A.	For Construction	G	
F	Fence line amended	LW	06/04/04	FD	P.A.	For review	F	
E	Fence line amended	LW	01/04/04	FD	P.A.	For review	E	
D	Dry pipe moved. Fenceline amended	LW	06/01/04	S.C.S	P.A.	For Construction	D	
C	Fenceline amended	LW	15/04/03	MC	P.A.	For Construction	C	
B	Fenceline amended. Roadbase amended	LW	24/03/03	M.Mc	P.A.	For Construction	B	
A	Fenceline amended	BE	13/03/03	B.E.	P.A.	For Review	A	



Project		M77 FENWICK - MALLET SHEUGH GLASGOW SOUTHERN ORBITAL (GSO) DBFO			Full Size
Title		FENCING LAYOUT SHEET 5 OF 13			A1
Scale	1:1000	Drawn	Checked	Approved	Drawing No.
		L.W.	P.A.	P.A.	S001DSG/DR/M77/F03/015
		Date	Date	Date	Rev
		24/02/03	24/02/03	24/02/03	I

Drawing Name & Location:
Plot Date:

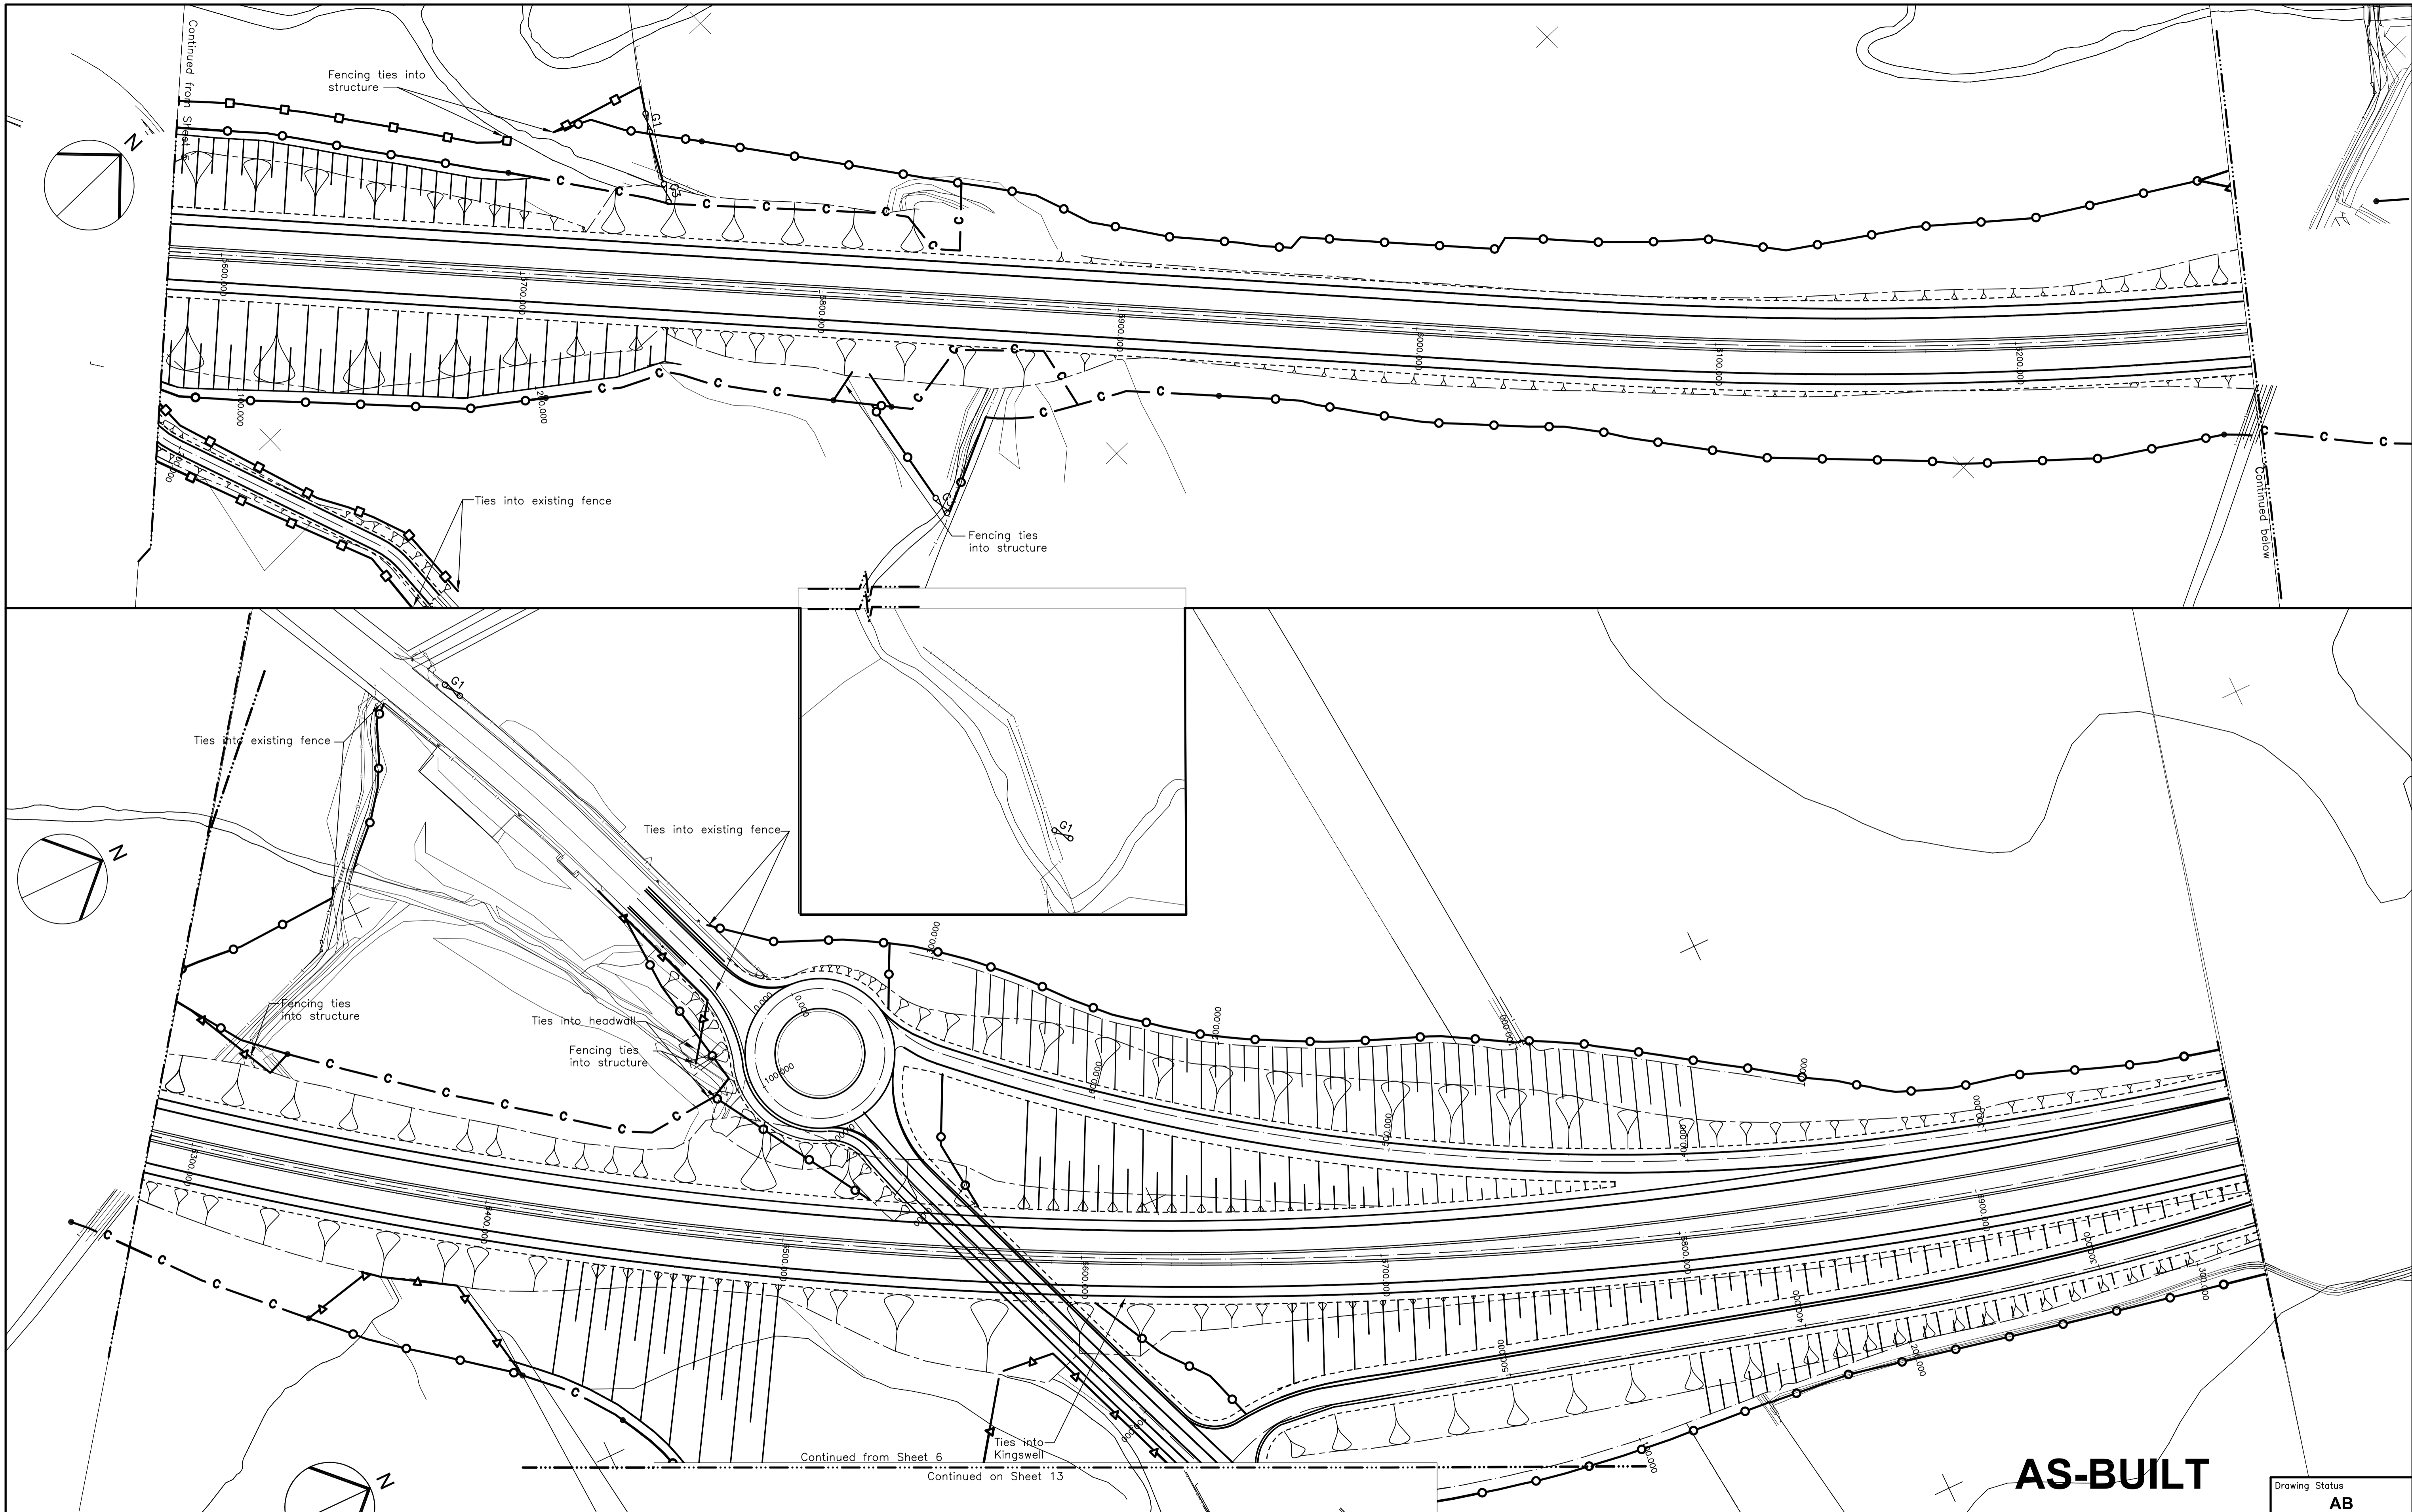

AS-BUILT

Drawing Status
AB

Notes :
For all notes refer to sheet 1





Rev	Description	By	Date	Chk'd	App'vd	Purpose of Issue	Rev	Client
J	Revised as per site notes	JB	03/11/05	DW	KOH	As Built	J	
I	Updated to As Built status	PC	08/08/05	DW	KOH	As Built	I	
H	Fencing amended	PC	14/03/05	PA	P.A.	For Construction	H	
G	Fencing at Kingswell amended	LW	04/10/04	PA	P.A.	For construction	G	
F	Fencing added. Sheet 13 added	PC	24/05/04	FD	P.A.	For Construction	F	
E	Fence line amended	LW	01/04/04	FD	P.A.	For review	E	
D	Fenceline amended	LW	06/01/04	S.C.S	P.A.	For Construction	D	
C	Fenceline amended	LW	15/04/03	MC	P.A.	For Construction	C	
B	Fenceline amended.	LW	24/03/03	M.McI	P.A.	For Construction	B	

Connect

Project		M77 FENWICK - MALLETSHEUGH GLASGOW SOUTHERN ORBITAL (GSO) DBFO			Full Size
Title		FENCING LAYOUT SHEET 6 OF 13			A1
Scale	1:1000	Drawn	Checked	Approved	Drawing No.
		L.W.	P.A.	P.A.	S001DSG/DR/M77/F03/016
		Date	Date	Date	Rev
		24/02/03	24/02/03	24/02/03	J

Drawing Name & Location:
Plot Date:

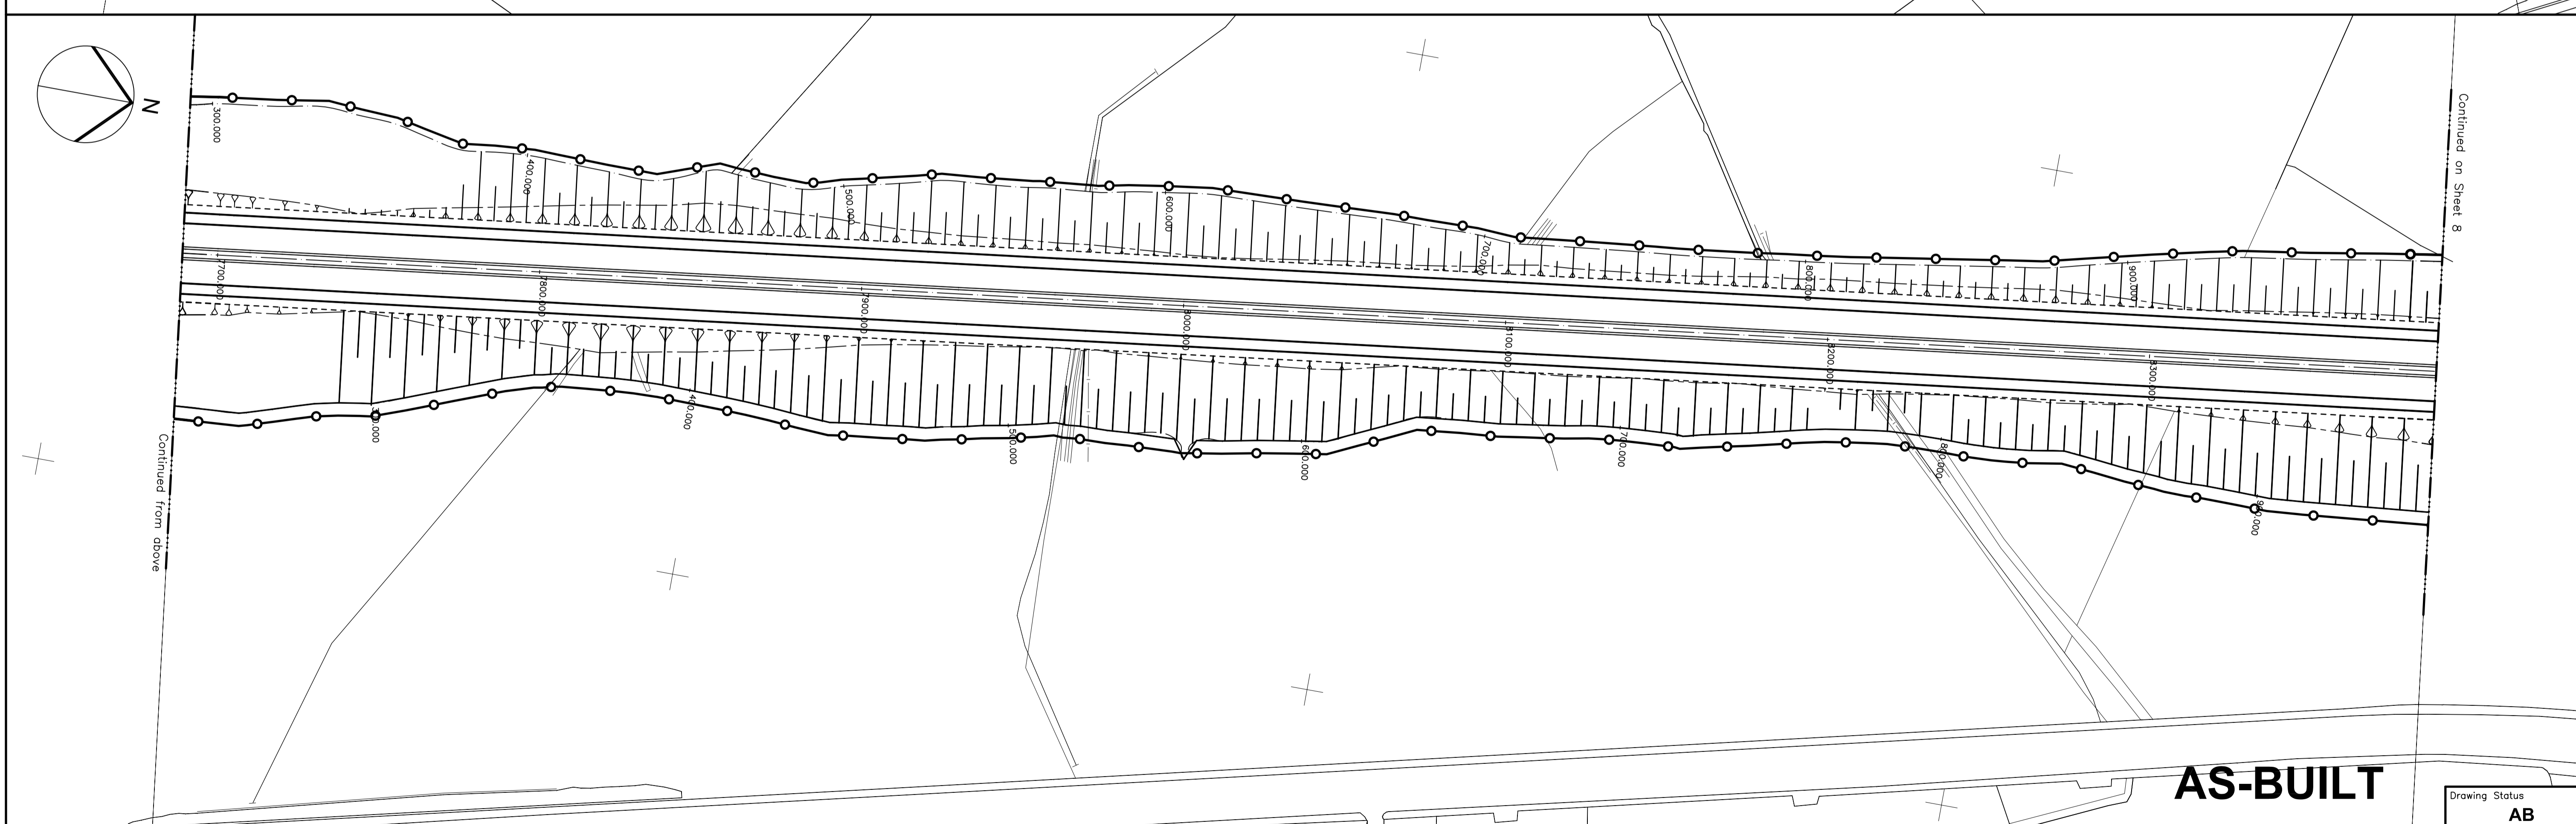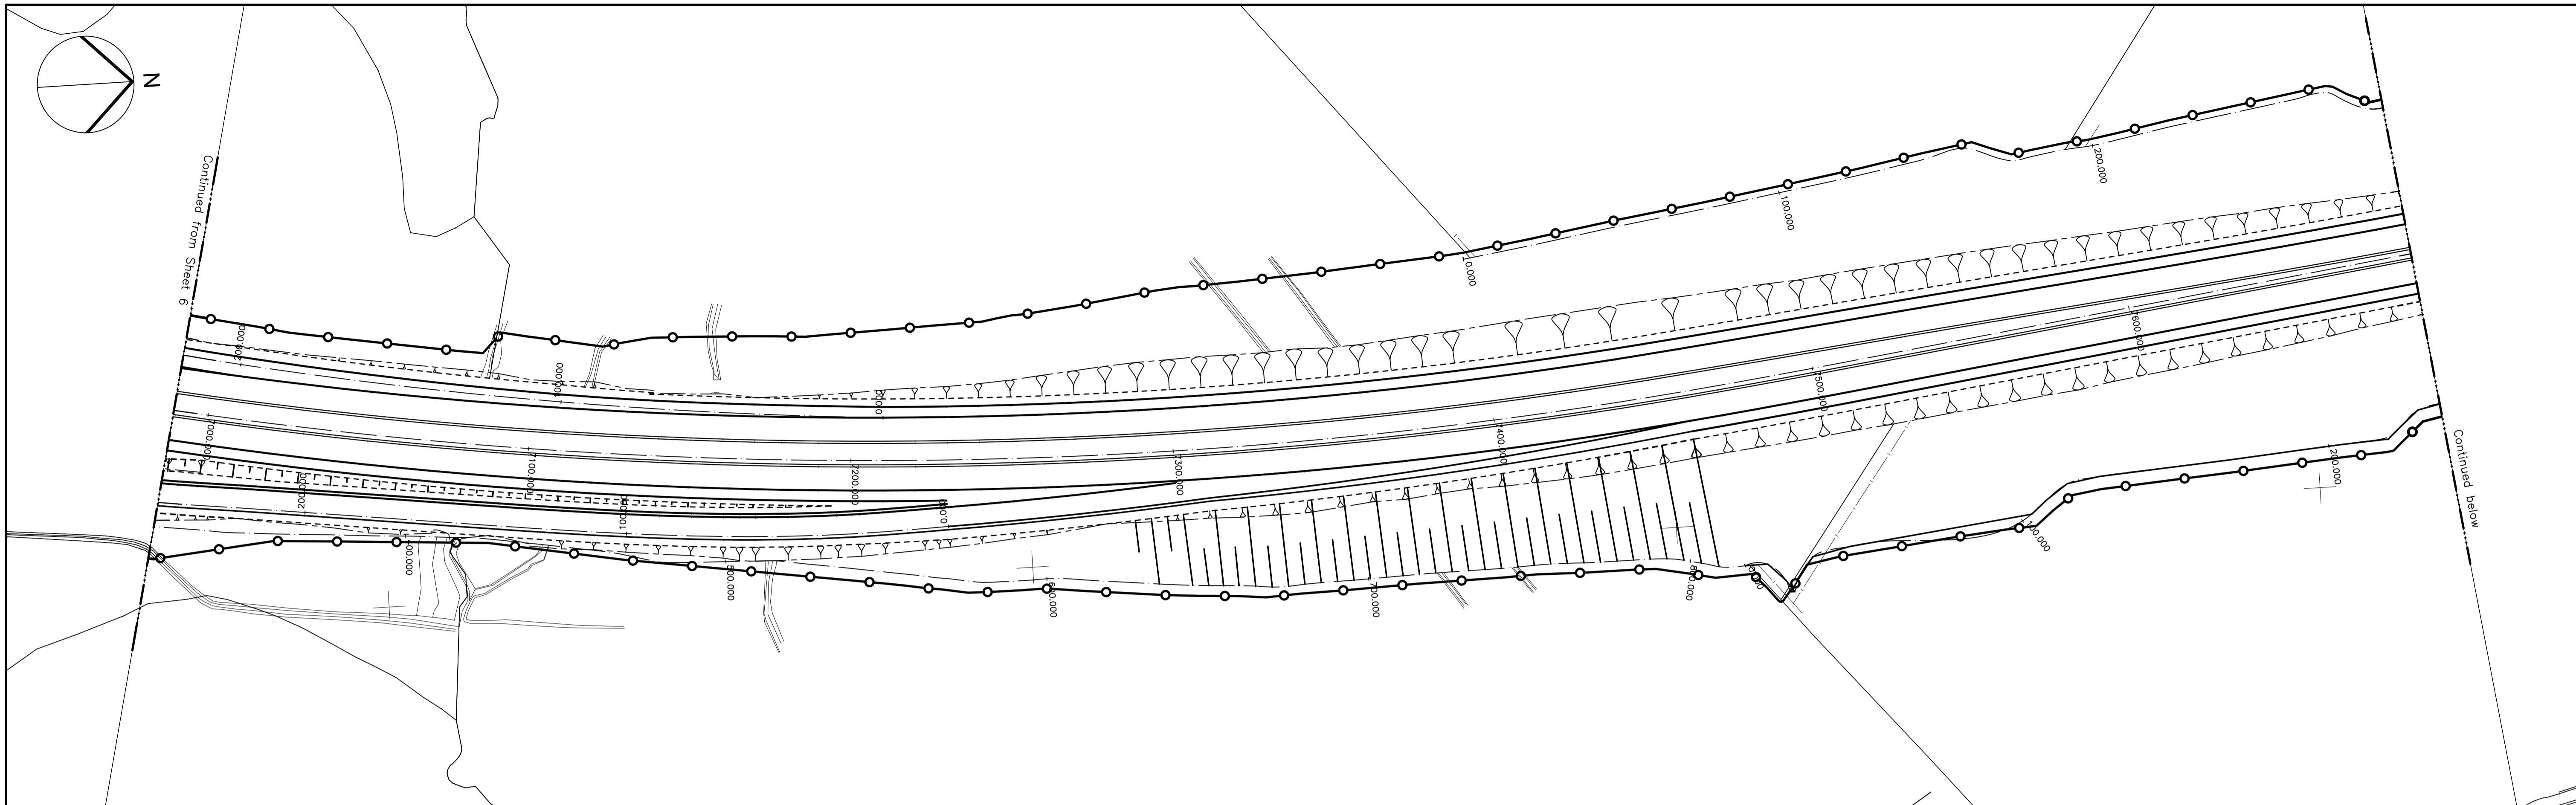

AS-BUILT

Drawing Status
AB

Notes :
For all notes refer to sheet 1





Rev	Description	By	Date	Chk'd	App'vd	Purpose of Issue	Rev	Client
G	Revised as per site notes	JB	03/11/05	DW	KOH	As Built	G	Connect
F	Updated to As Built status	PC	08/08/05	DW	KOH	As Built	F	
E	Fenceline amended between Ch 7000-7200	LW	04/10/04	PA	P.A.	For construction	E	
D	Sheet 13 added	PC	24/05/04	FD	P.A.	For Construction	D	
C	For review	LW	01/03/04	M.Mc	P.A.	For review	C	
B	Roadbase amended	LW	24/03/03	M.Mc	P.A.	For Construction	B	
A	Fenceline amended	BE	13/03/03	B.E.	P.A.	For Review	A	
0	First Issue	LW	17/02/03	P.A.	P.A.	For Review	0	

Connect

Project		M77 FENWICK - MALLETSHEUGH GLASGOW SOUTHERN ORBITAL (GSO) DBFO			Full Size
Title		FENCING LAYOUT SHEET 7 OF 13			A1
Scale	1:1000	Drawn	Checked	Approved	Drawing No.
		L.W.	P.A.	P.A.	S001DSG/DR/M77/F03/017
		Date	Date	Date	Rev
		17/02/03	17/02/03	17/02/03	G

Drawing Name & Location:
Plot Date:

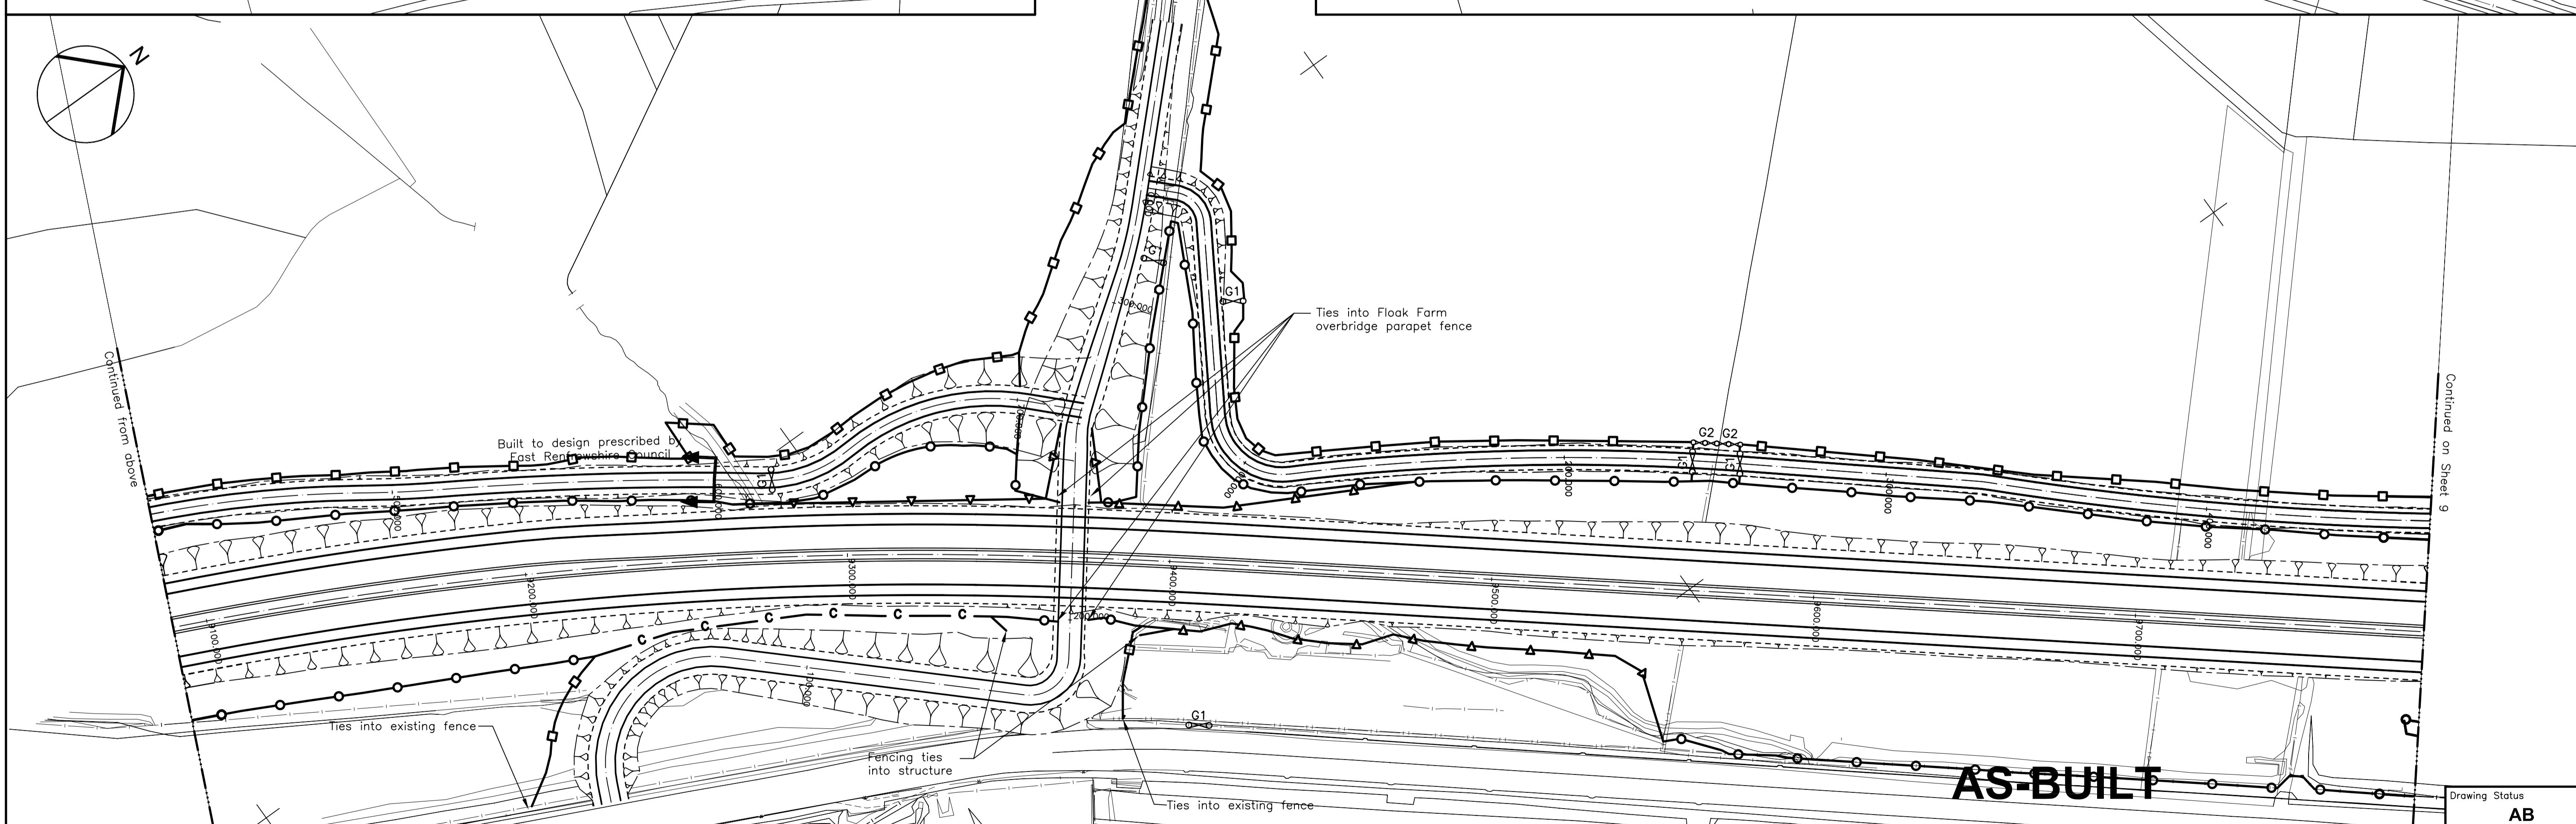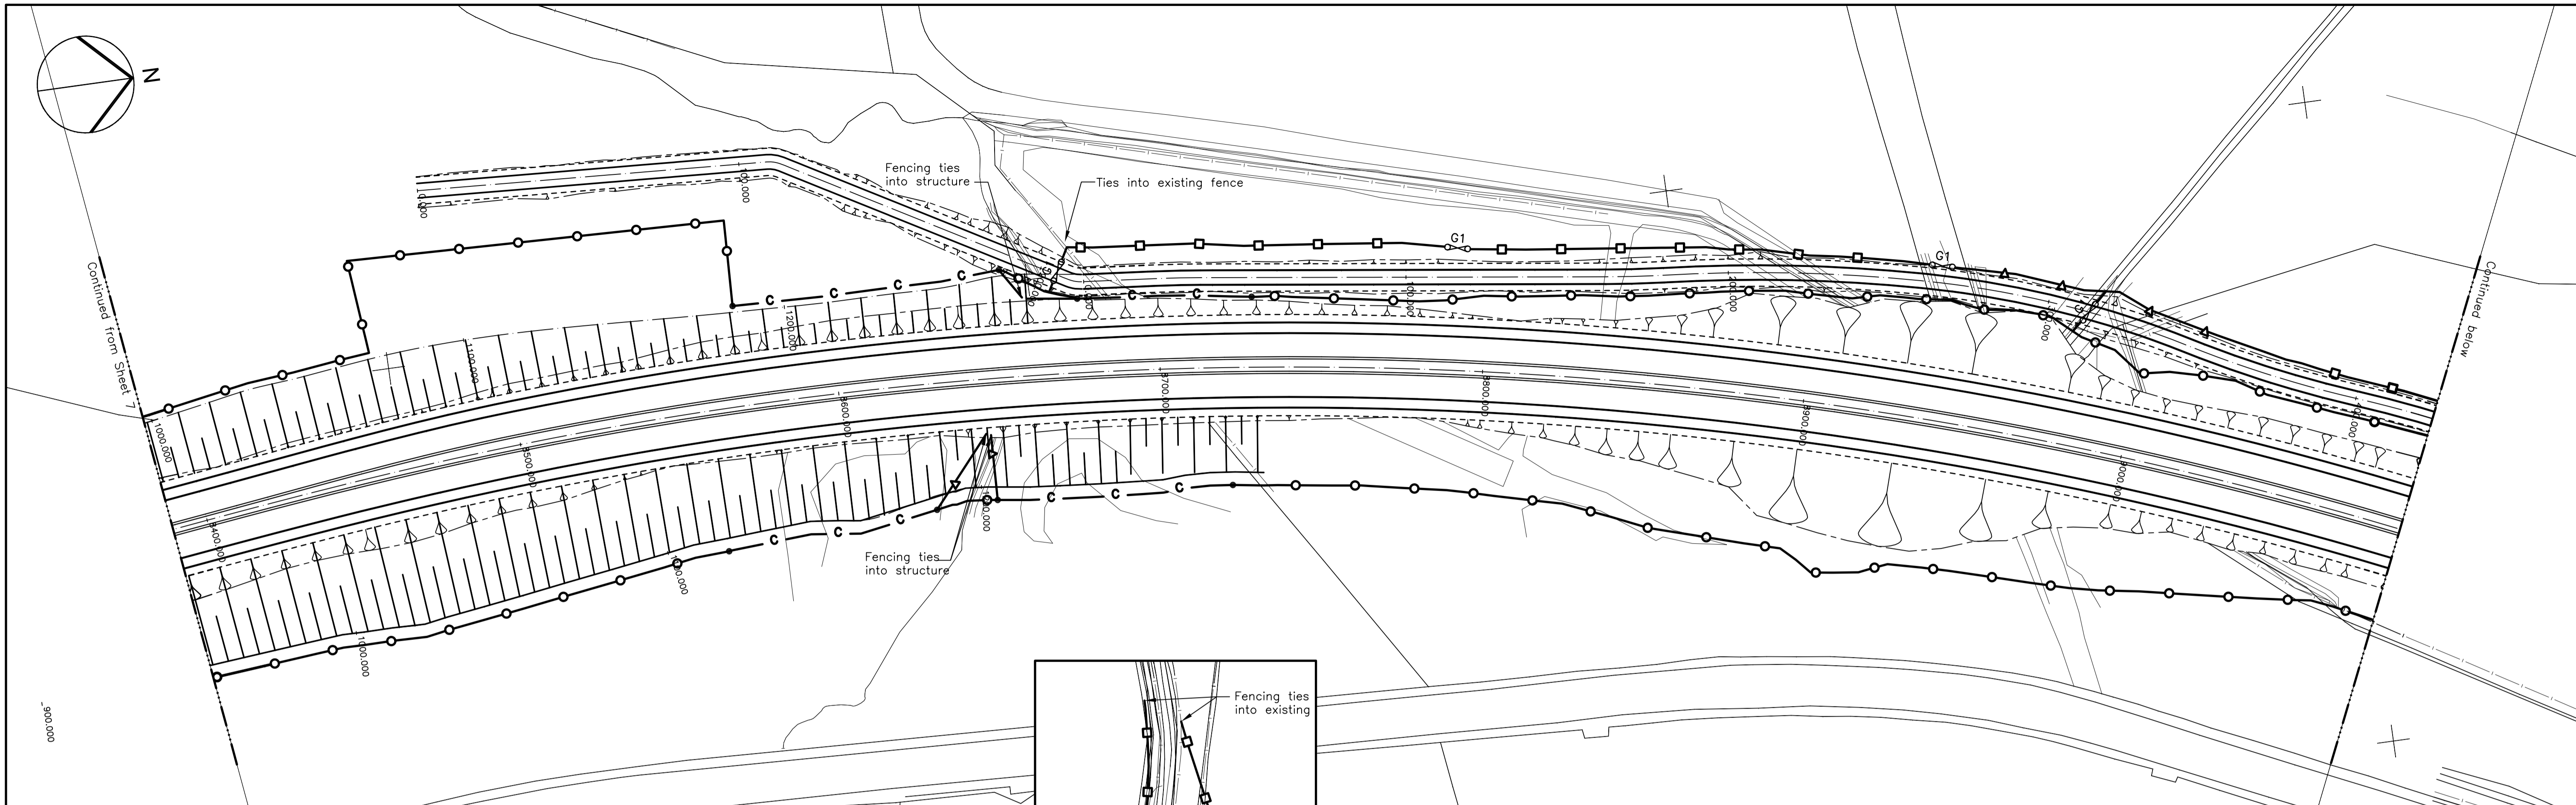

AS-BUILT

Drawing Status
AB

Notes :
For all notes refer to sheet 1



Rev	Description	By	Date	Chk'd	App'vd	Purpose of Issue	Rev	Client
L	Revised as per site notes	JB	03/11/05	DW	KOH	As Built	L	Connect
K	Updated to As Built status	PC	08/08/05	DW	KOH	As Built	K	
J	Anti-dazzle measures removed	PC	31/03/05	PA	P.A.	For Construction	J	
I	Anti-dazzle measures added	PC	26/01/05	PA	P.A.	For Construction	I	
H	Fencing added, Sheet 13 added	PC	24/05/04	FD	P.A.	For Construction	H	
G	Fence line amended	LW	01/04/04	FD	P.A.	For review	G	
F	Dry pipe positions updated	LW	06/01/04	S.C.S	P.A.	For Construction	F	
E	Fenceline amended	PC	22/10/03	AC	P.A.	For Construction	E	
D	Fenceline amended	LW	30/06/03	AC	P.A.	For Construction	D	

Project		M77 FENWICK - MALLET SHEUGH GLASGOW SOUTHERN ORBITAL (GSO) DBFO			Full Size
Title		FENCING LAYOUT SHEET 8 OF 13			A1
Scale	1:1000	Drawn	Checked	Approved	Drawing No.
		L.W.	P.A.	P.A.	S001DSG/DR/M77/F03/018
		Date	Date	Date	Rev
		17/02/03	17/02/03	17/02/03	L

Drawing Name & Location:
Plot Date: