




RESIDUAL DESIGN HAZARDS

1. Refer to document CO21000101/DO2.3/D1 for Designer's Hazard Management Schedule


NOTES

1. All dimensions in millimetres and chainages in metres, unless otherwise stated.
2. This drawing should only be used for the purposes of the Design Element stated in the drawing title.
3. Basin to be constructed of class 2A material.

LEGEND

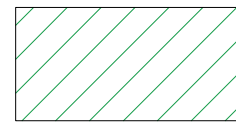

Wetland Planting

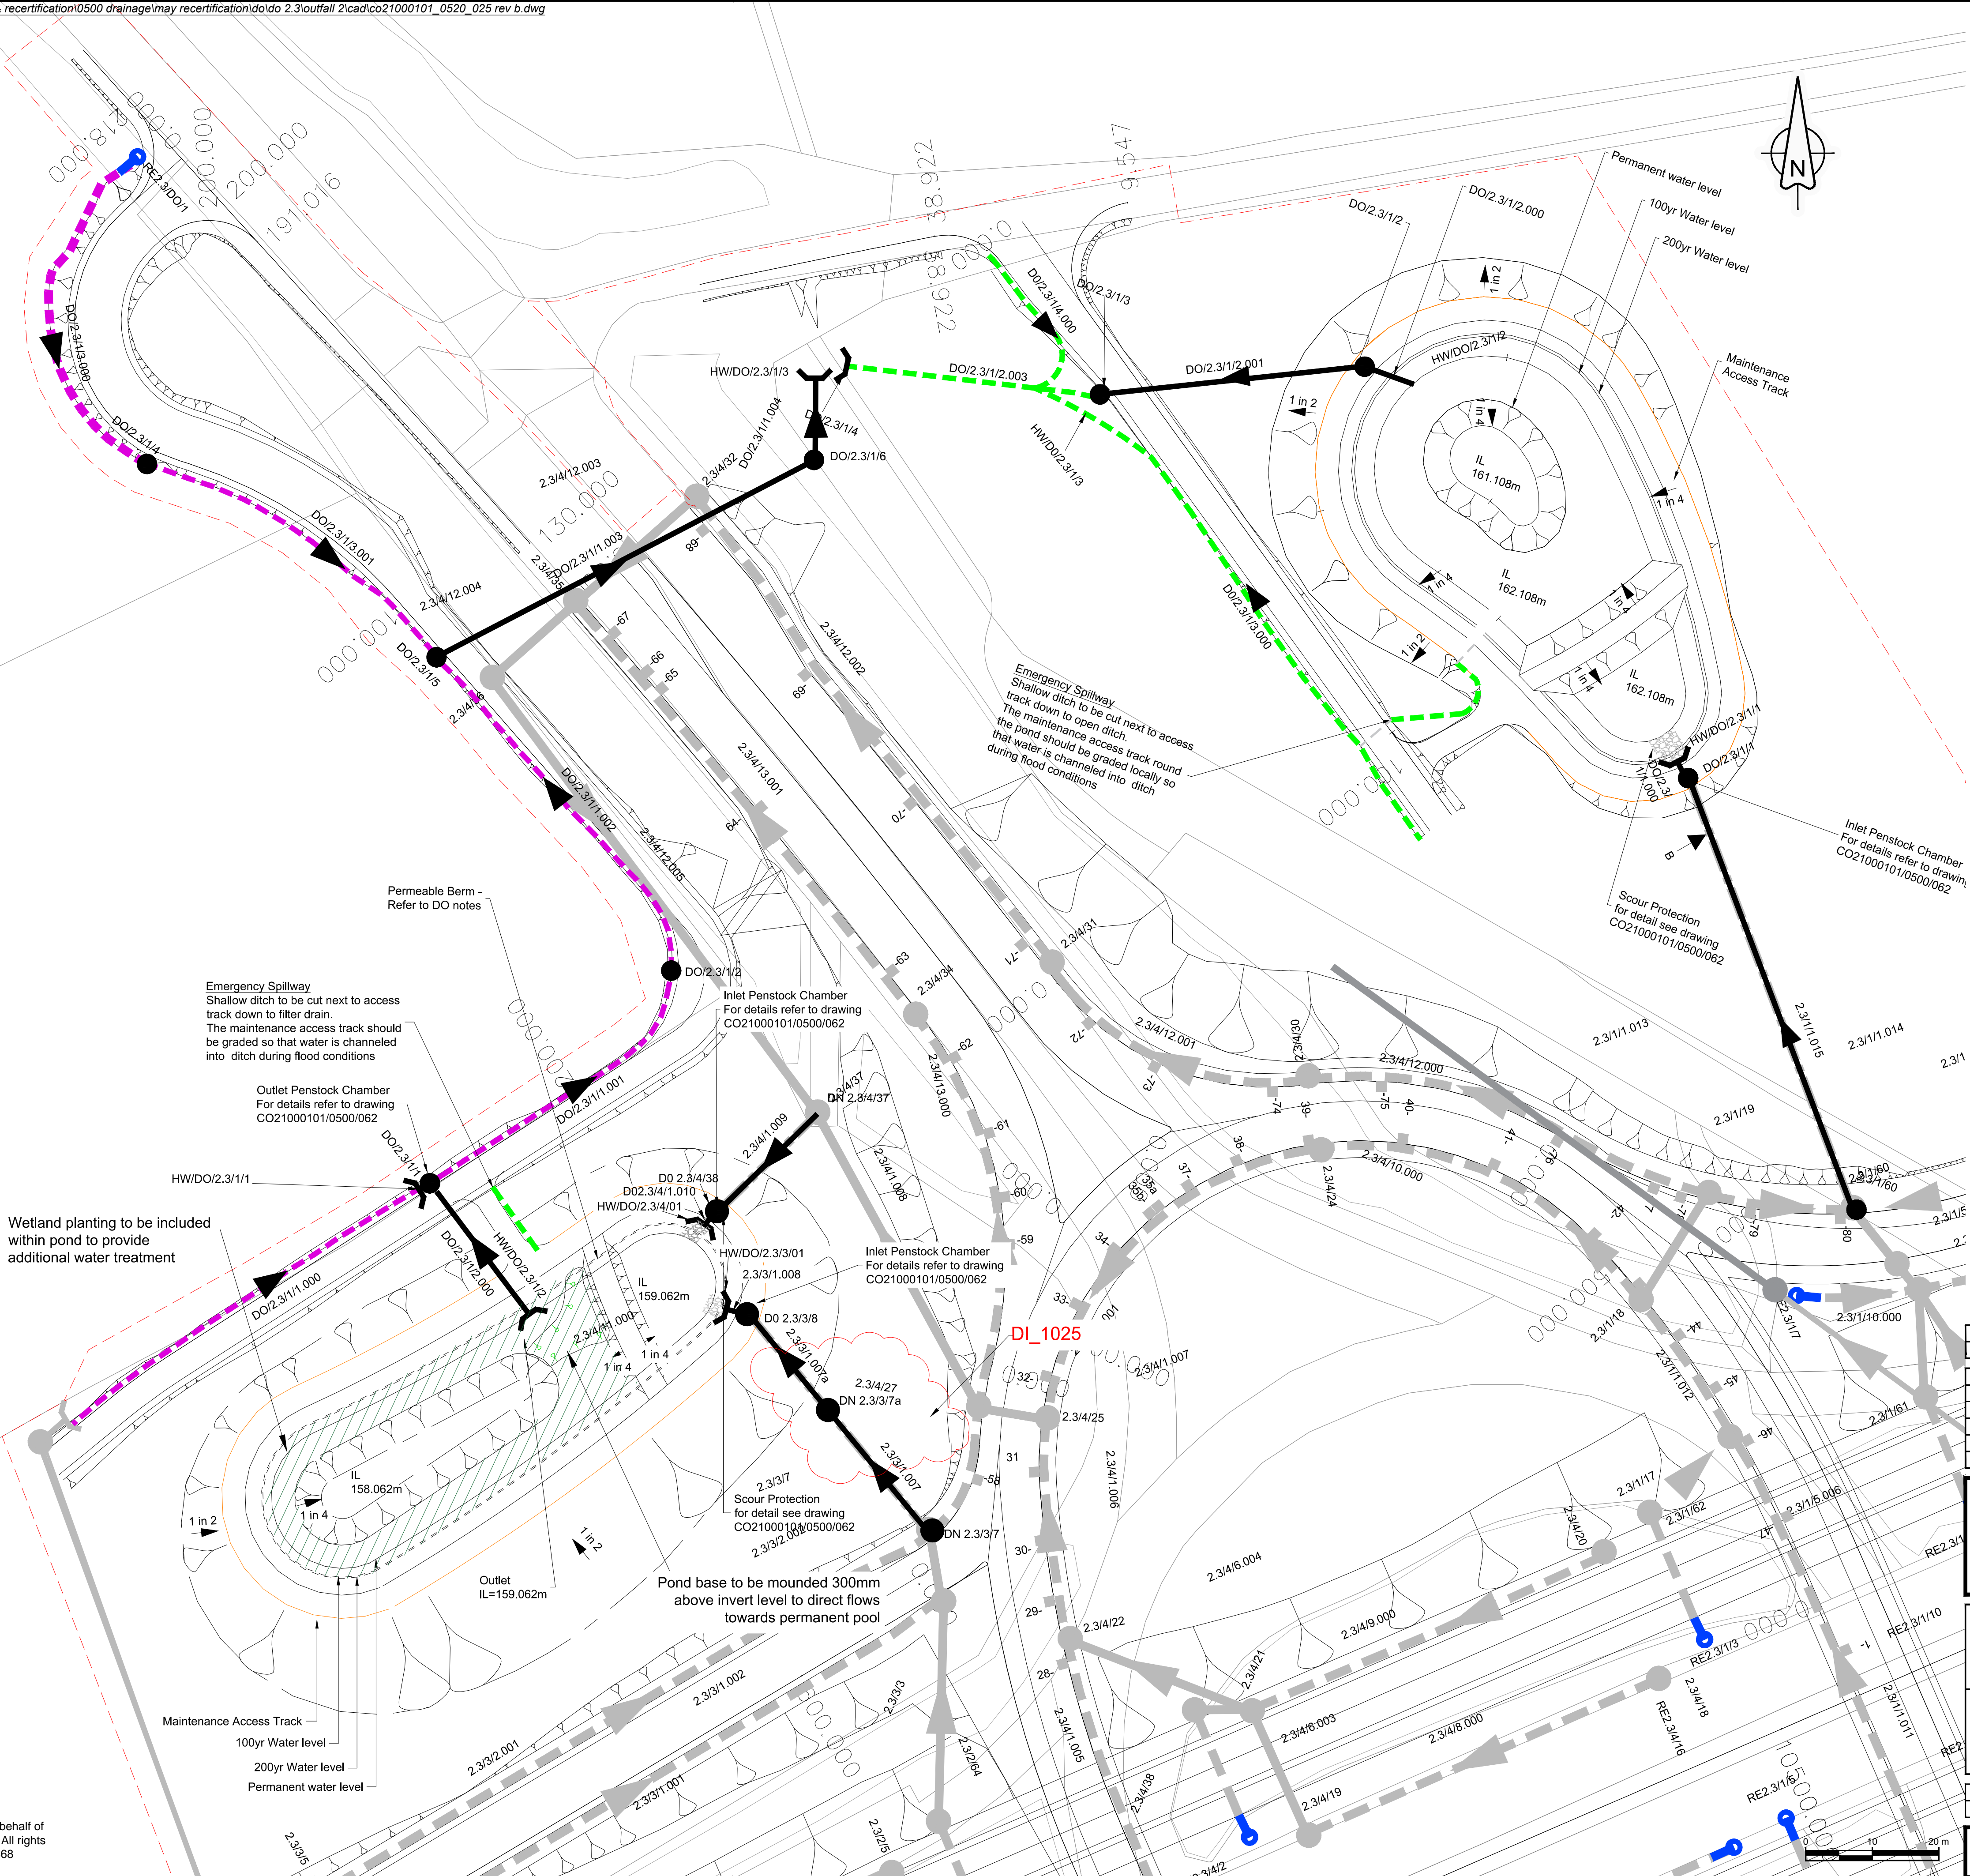

D	DI 1025 incorporated	GM	CM	20.06.17
Rev	Revision details	Chkd	Appd	Date

Drawn: JF	Preliminary
Design: TD	For Comment
Chkd: AW	For Review
Appd: GMacD	For Construction
Date: 09/09/2014	As Constructed
	Other



Project Name
M8 M73 M74 MOTORWAY IMPROVEMENTS

Drawing Title
**DRAINAGE OUTFALL
Section 2.3 - Outfall 2 - Plan**

Original Drawing Size : A1	Dimensions : Metres
Scale : 1:500	Copyright © Amey

Drawing No CO21000101/0520/025	Rev D
--	-----------------