
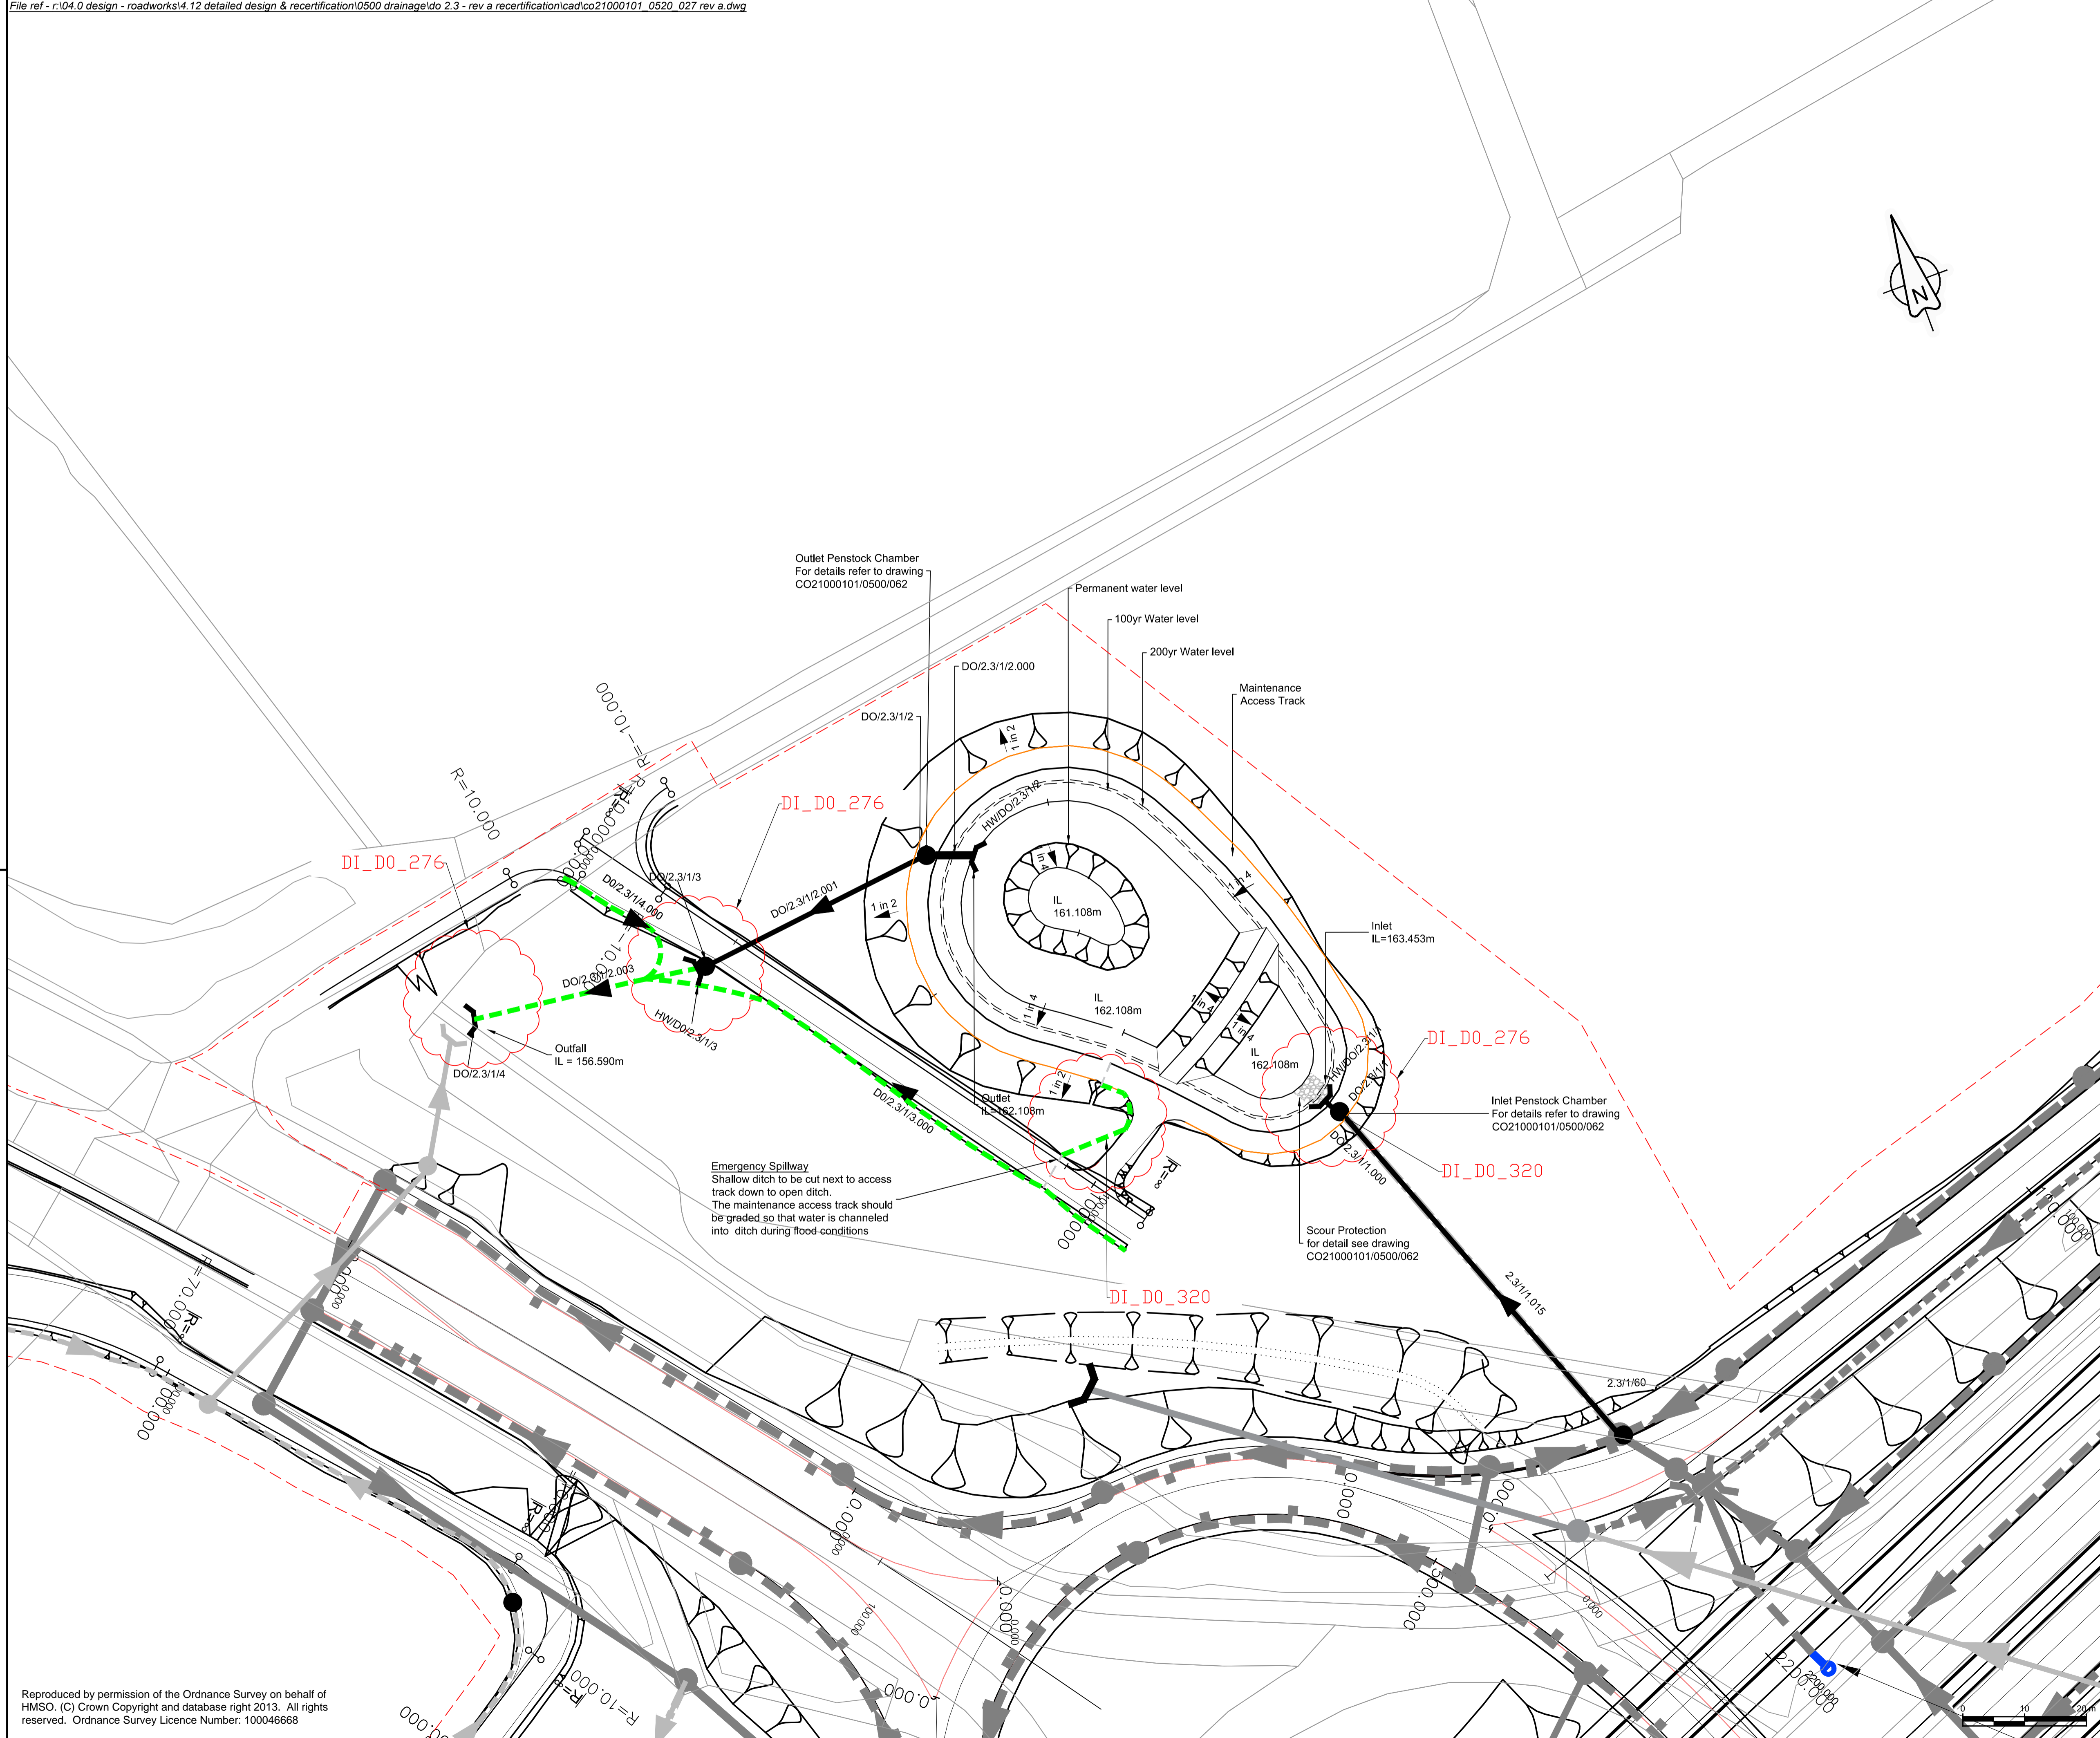


RESIDUAL DESIGN HAZARDS

1. Refer to document CO21000101/DO2.3/D1 for Designer's Hazard Management Schedule

- NOTES**
1. All dimensions in millimetres and chainages in metres, unless otherwise stated.
 2. This drawing should only be used for the purposes of the Design Element stated in the drawing title.
 3. Basin to be constructed of class 2A material.

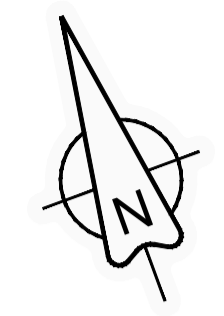

A	DI 276 and DI 320	GL	BL	31/03/16
Rev	Revision details	Chkd	Appd	Date
Drawn:	MC	Preliminary		
Design:	TD	For Comment		
Chkd:	AW	For Review		
Appd:	GM	For Construction <input checked="" type="checkbox"/>		
Date:	09-09-2014	As Constructed		
		Other		

Project Name
M8 M73 M74 MOTORWAY IMPROVEMENTS
 Drawing Title
DRAINAGE OUTFALL Section 2.3 - Outfall 3 - Plan

Original Drawing Size : A1	Dimensions : Metres
Scale : 1:500	Copyright © Amey

Drawing No CO21000101/0520/027	Rev A
-----------------------------------	----------