
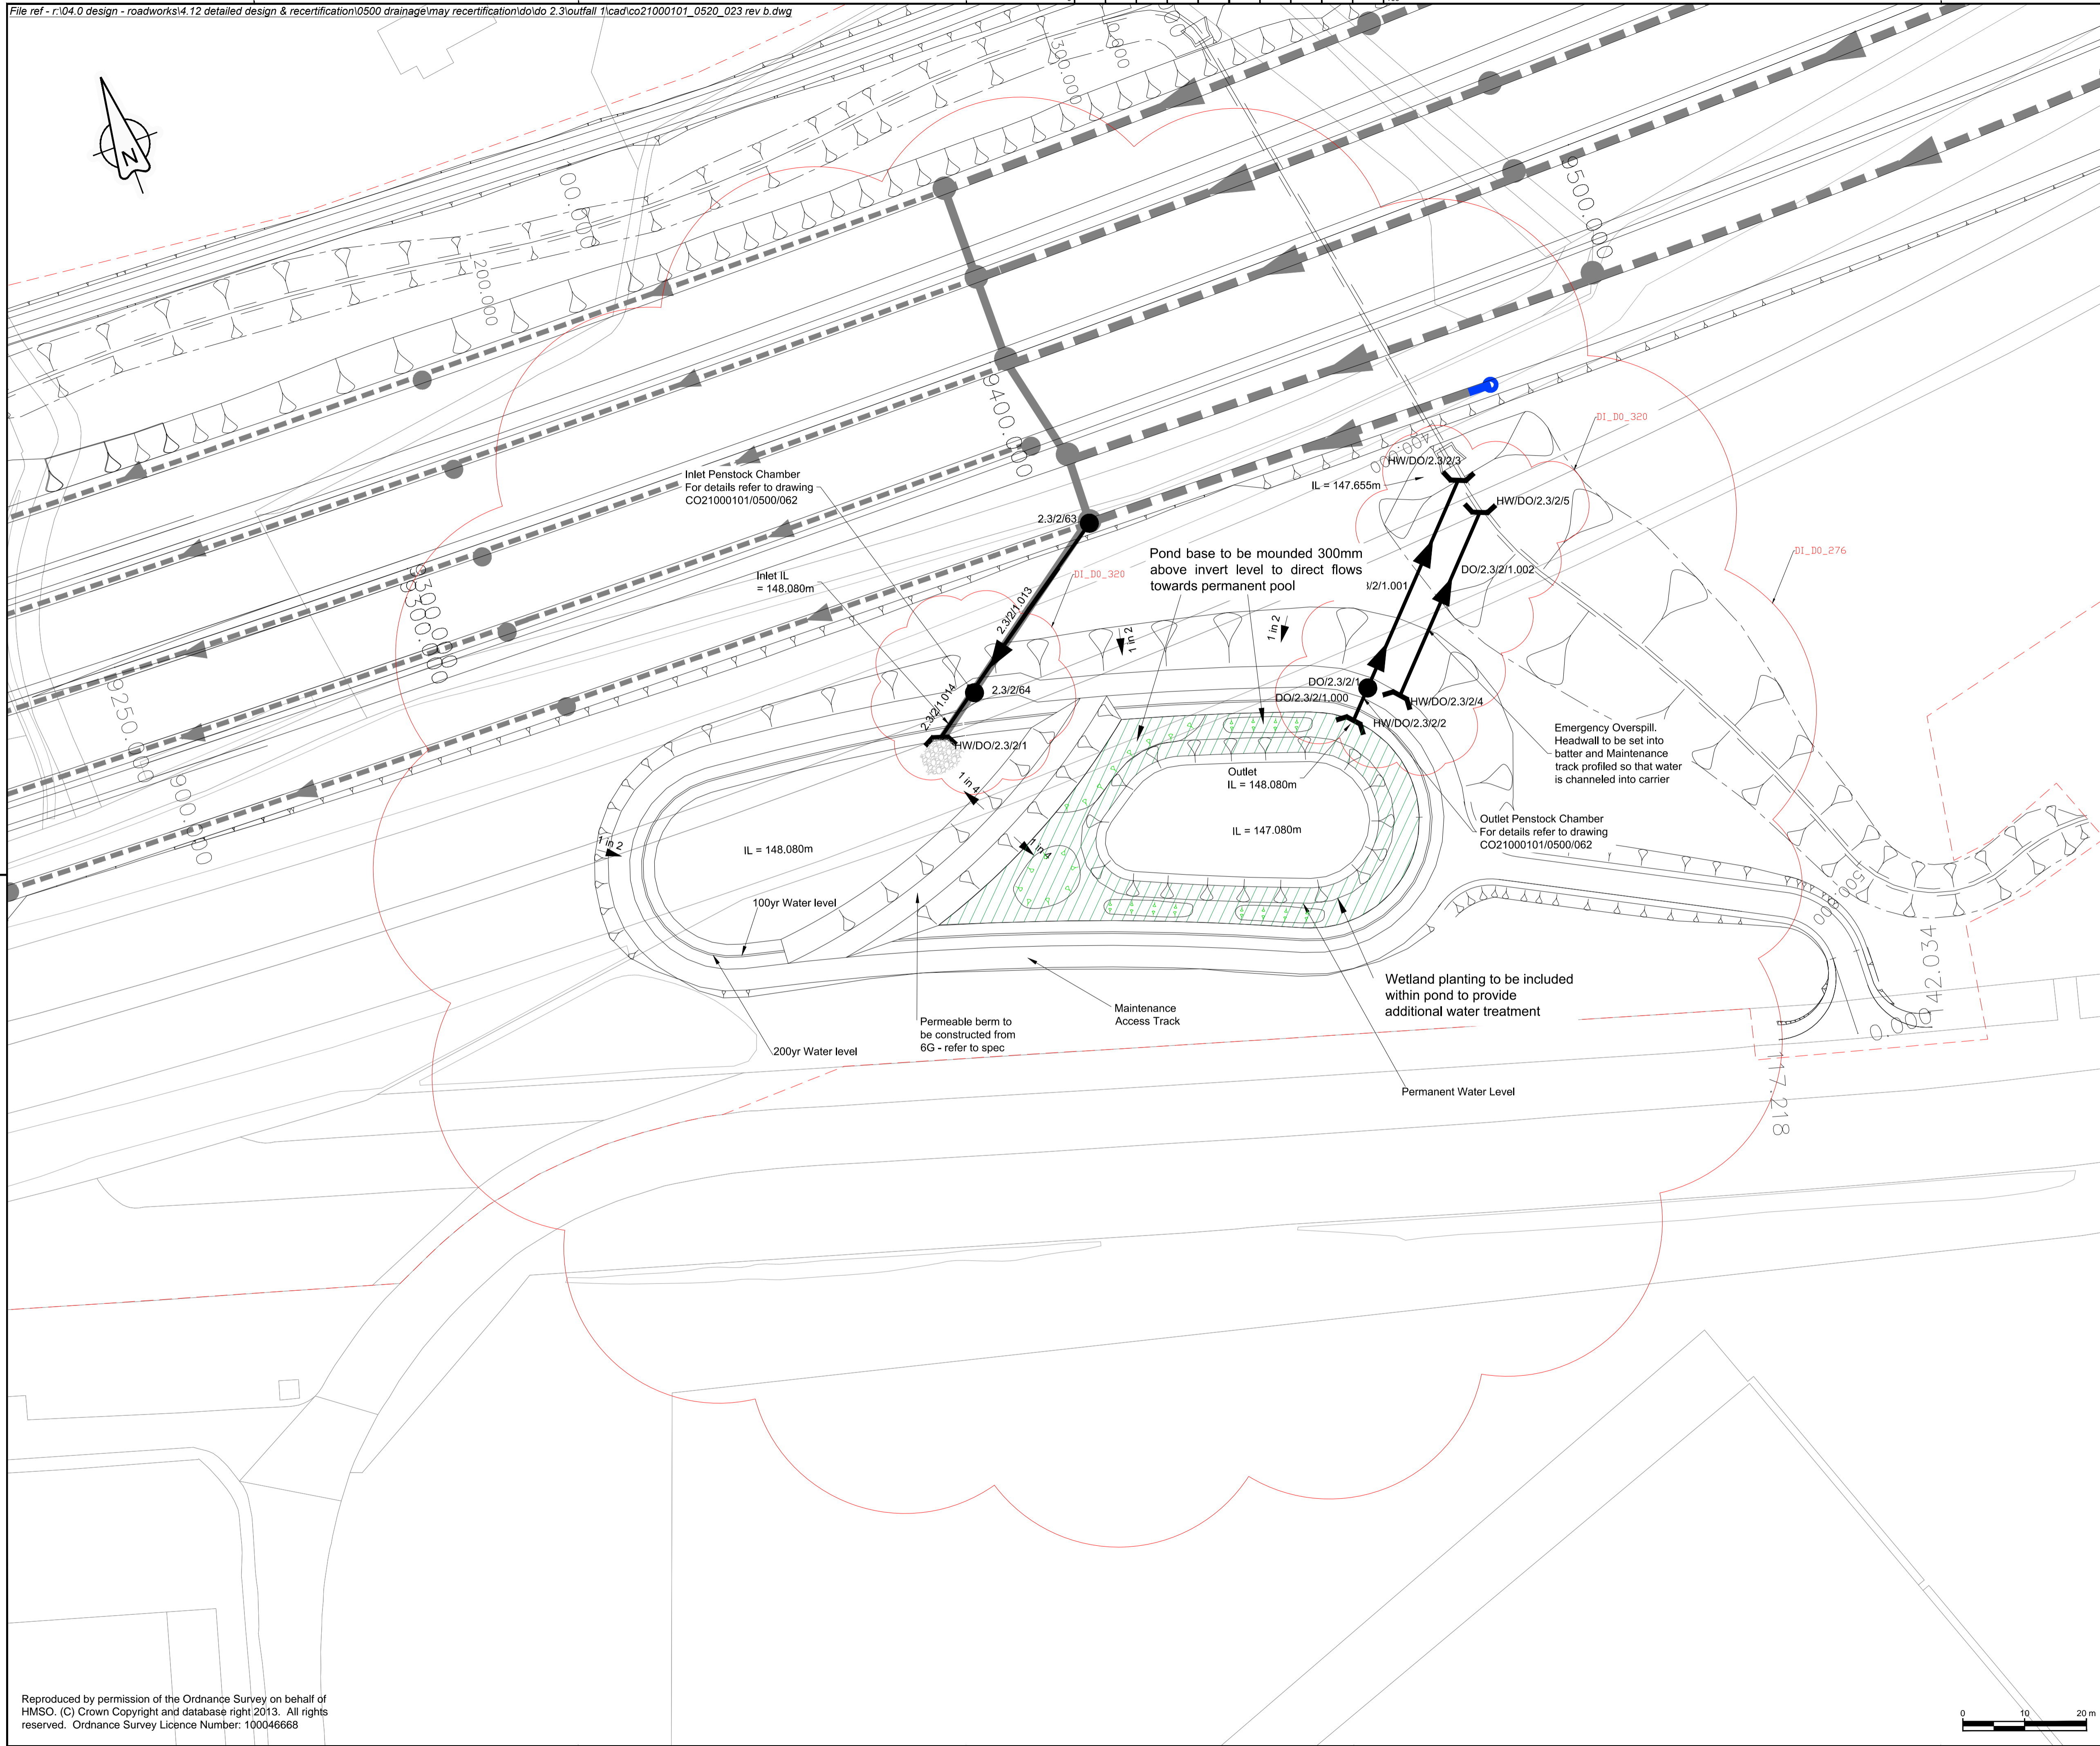


**RESIDUAL DESIGN HAZARDS**  
 1. Refer to document CO21000101/DO2.3/D1 for Designer's Hazard Management Schedule

- NOTES**
- All dimensions in millimetres and chainages in metres, unless otherwise stated.
  - This drawing should only be used for the purposes of the Design Element stated in the drawing title.
  - Basin to be constructed of class 2A material.

**LEGEND**

 Wetland Planting



B	Wetland planting added	SC	CM	22/05/17
A	DI 276 and 320	GL	BL	31/03/16
Rev	Revision details	Chkd	Appd	Date

Drawn: PS	Preliminary
Design: SC	For Comment
Chkd: AW	For Review
Appd: GM	For Construction <input checked="" type="checkbox"/>
Date: 15/09/2014	As Constructed
	Other

**M8 M73 M74** Motorway Improvements  
**Scottish Roads** Partnership  
**RPS** **amey**

Project Name  
**M8 M73 M74 MOTORWAY IMPROVEMENTS**

Drawing Title  
**DRAINAGE OUTFALL Section 2.3 - Outfall 1 - Plan**

Original Drawing Size : A1	Dimensions : Metres
Scale : 1:500	Copyright © Amey

Drawing No CO21000101/0520/023	Rev B
-----------------------------------	----------